


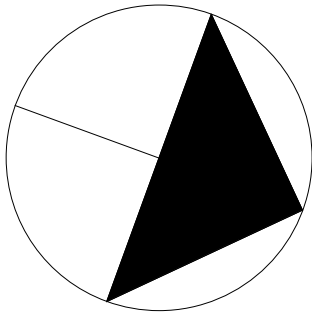


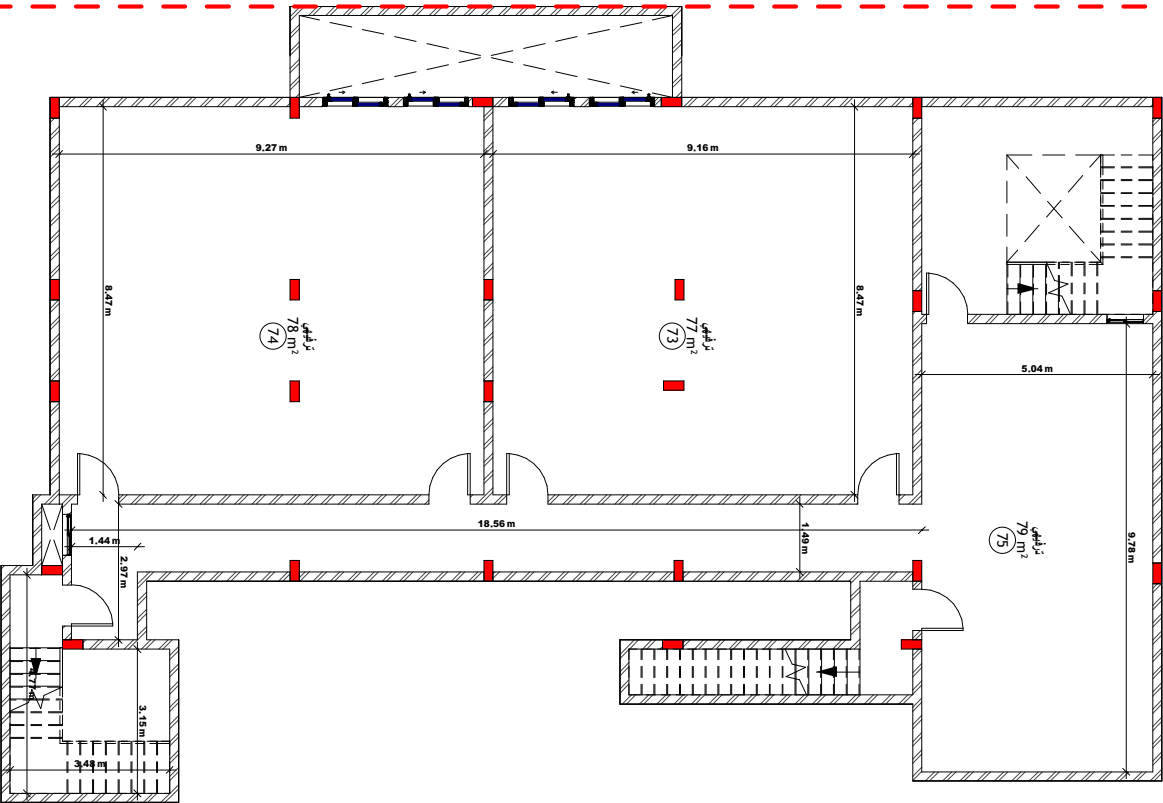



	PROJECT NAME	DRAWING TITLE	DESIGNED BY	DRAWING NUM.	DATE		
	RAWDA COMPOUND	AS BUILT FLOOR PLANS	ARC. ABDELRAHMAN	A101	10/04/25		
	CLINT NAME	FLOOR TITLE	CHECKED BY	APPROVED BY	SCALE		
	ABNAA EL ZEEYIEB	BASEMENT	ARC. OSAMA & ARC. FAISAL	ARC. YOUSEF	1 : 150		

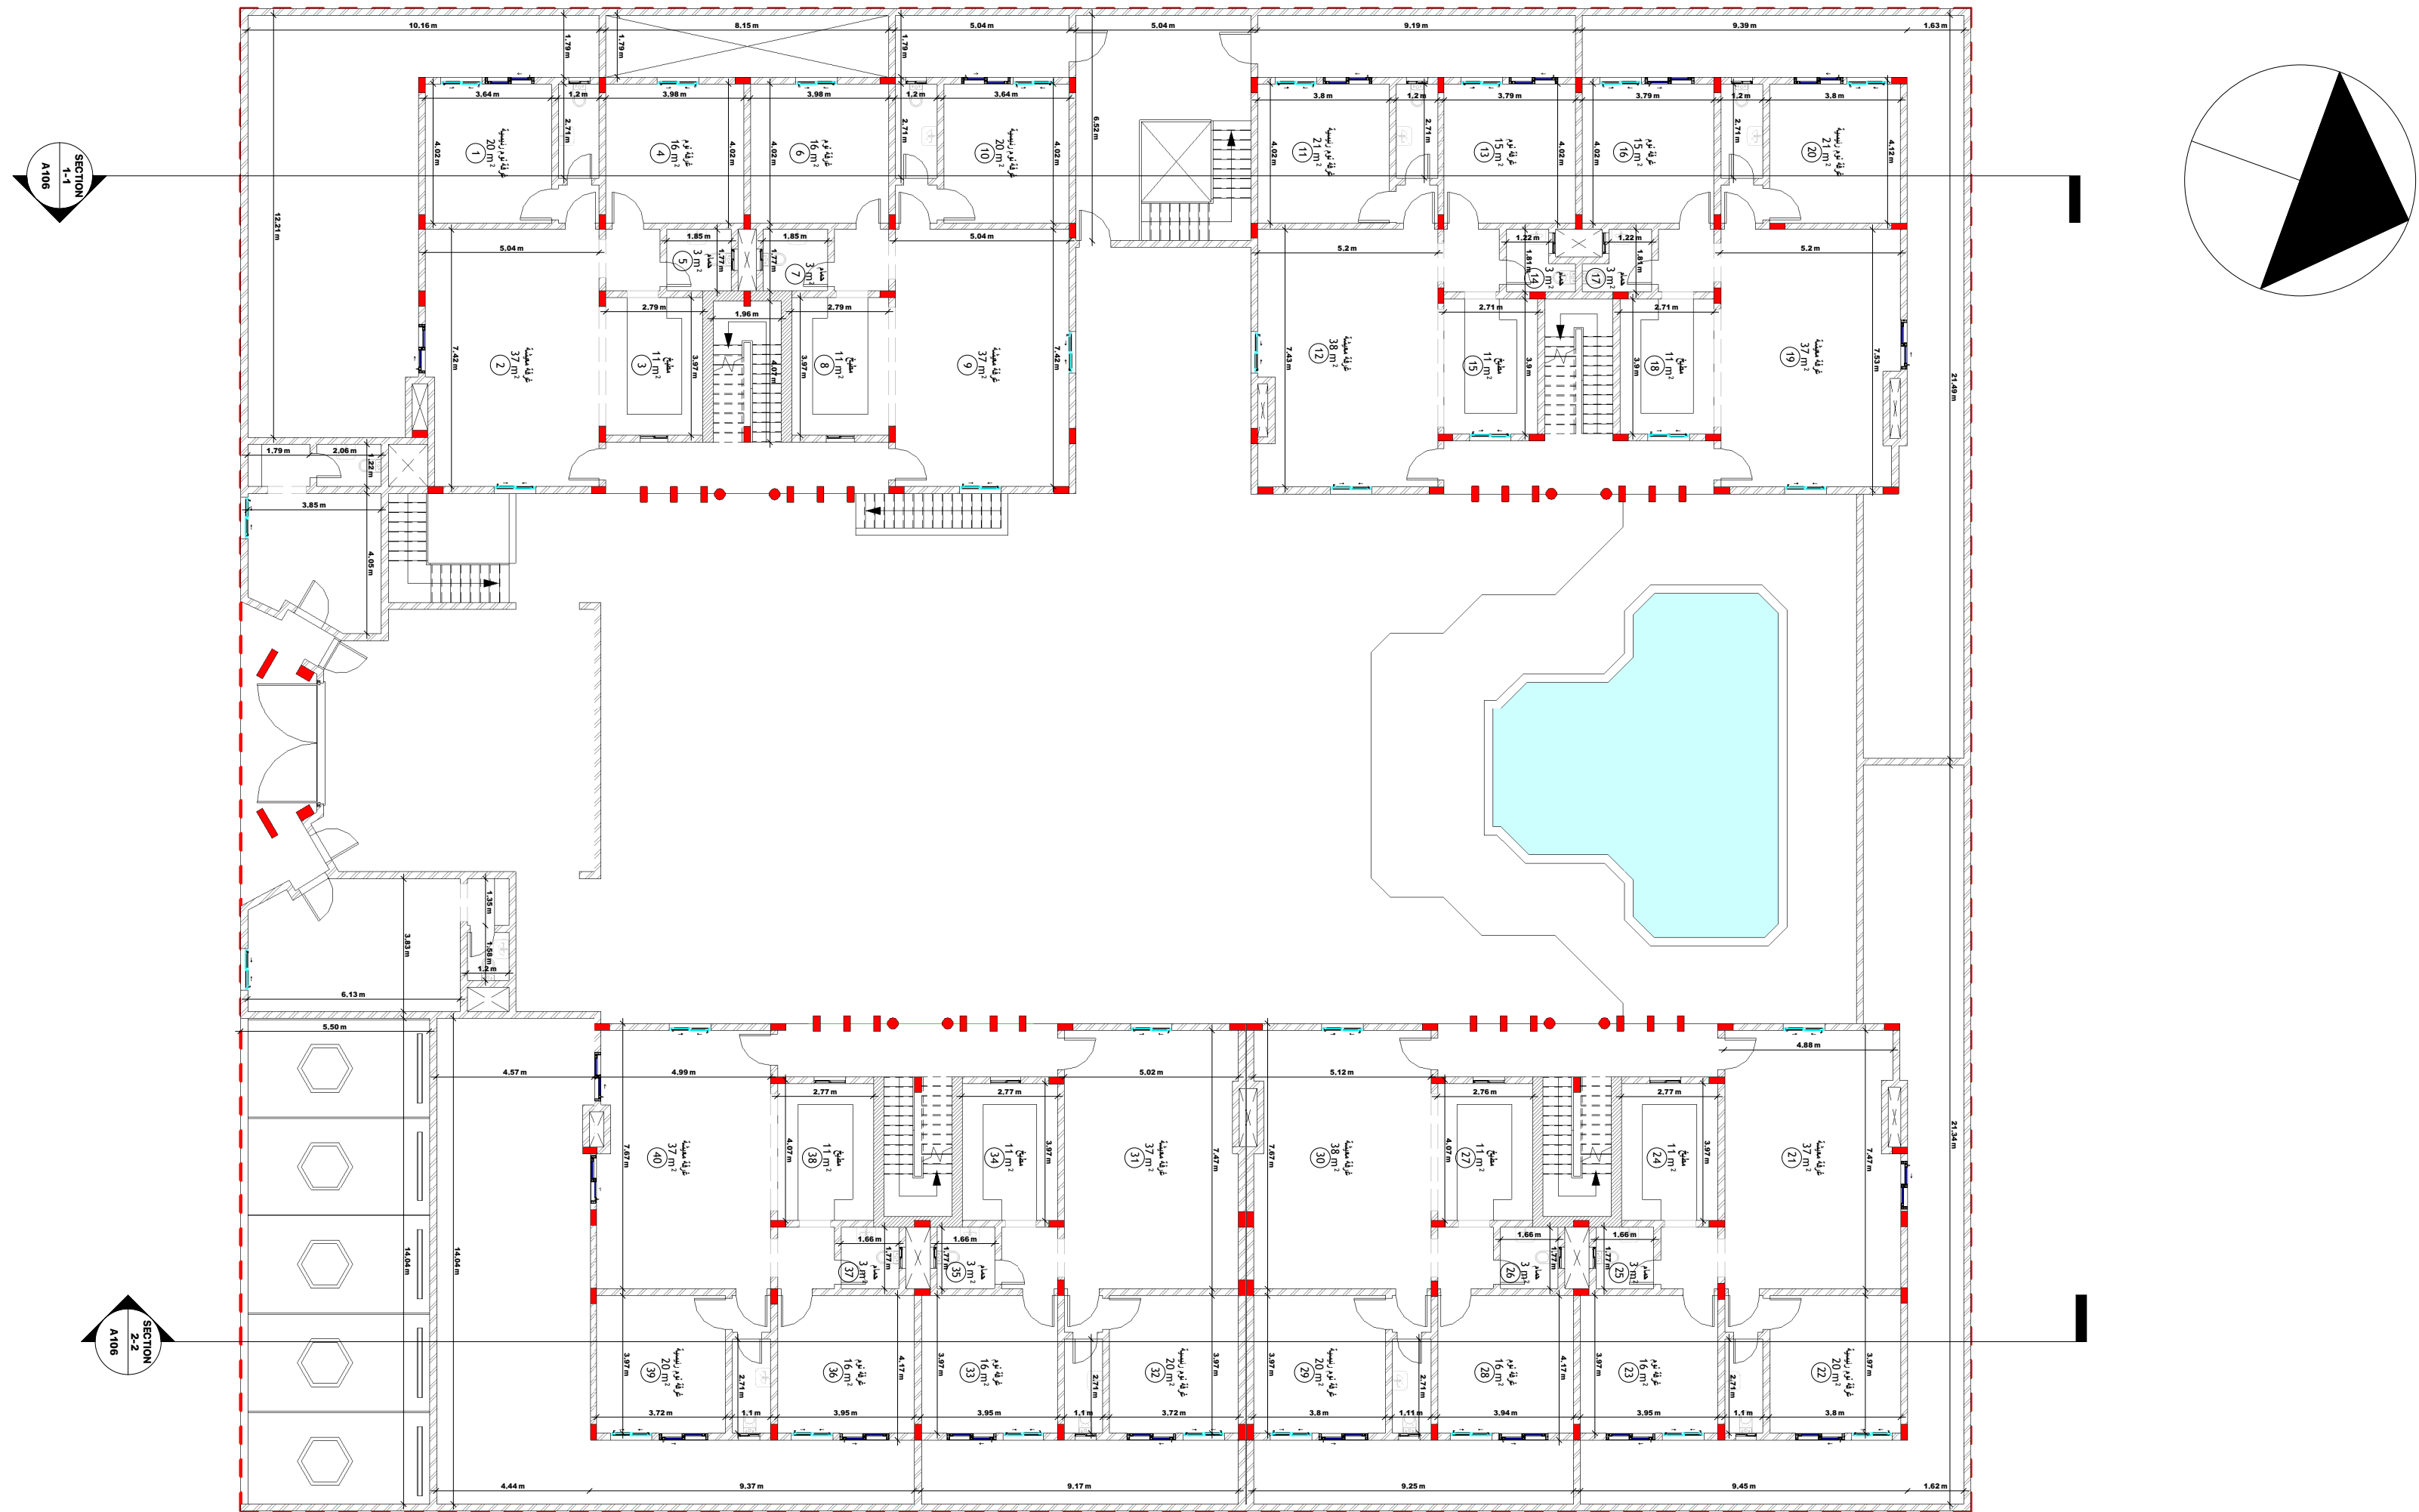


PROJECT NAME	DRAWING TITLE	DESIGNED BY	DRAWING NUM.	DATE
RAWDA COMPOUND	AS BUILT FLOOR PLANS	ARC. ABDELRAHMAN	A102	10/04/25
CLINT NAME	FLOOR TITLE	CHECKED BY	APPROVED BY	SCALE
ABNAA EL ZEEYIEB	GROUND FLOOR PLAN	ARC. OSAMA & ARC. FAISAL	ARC. YOUSEF	1 : 150

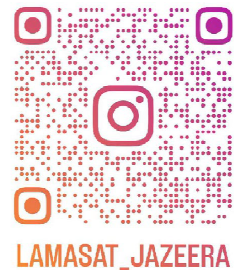





LAMASAT_JAZEERA

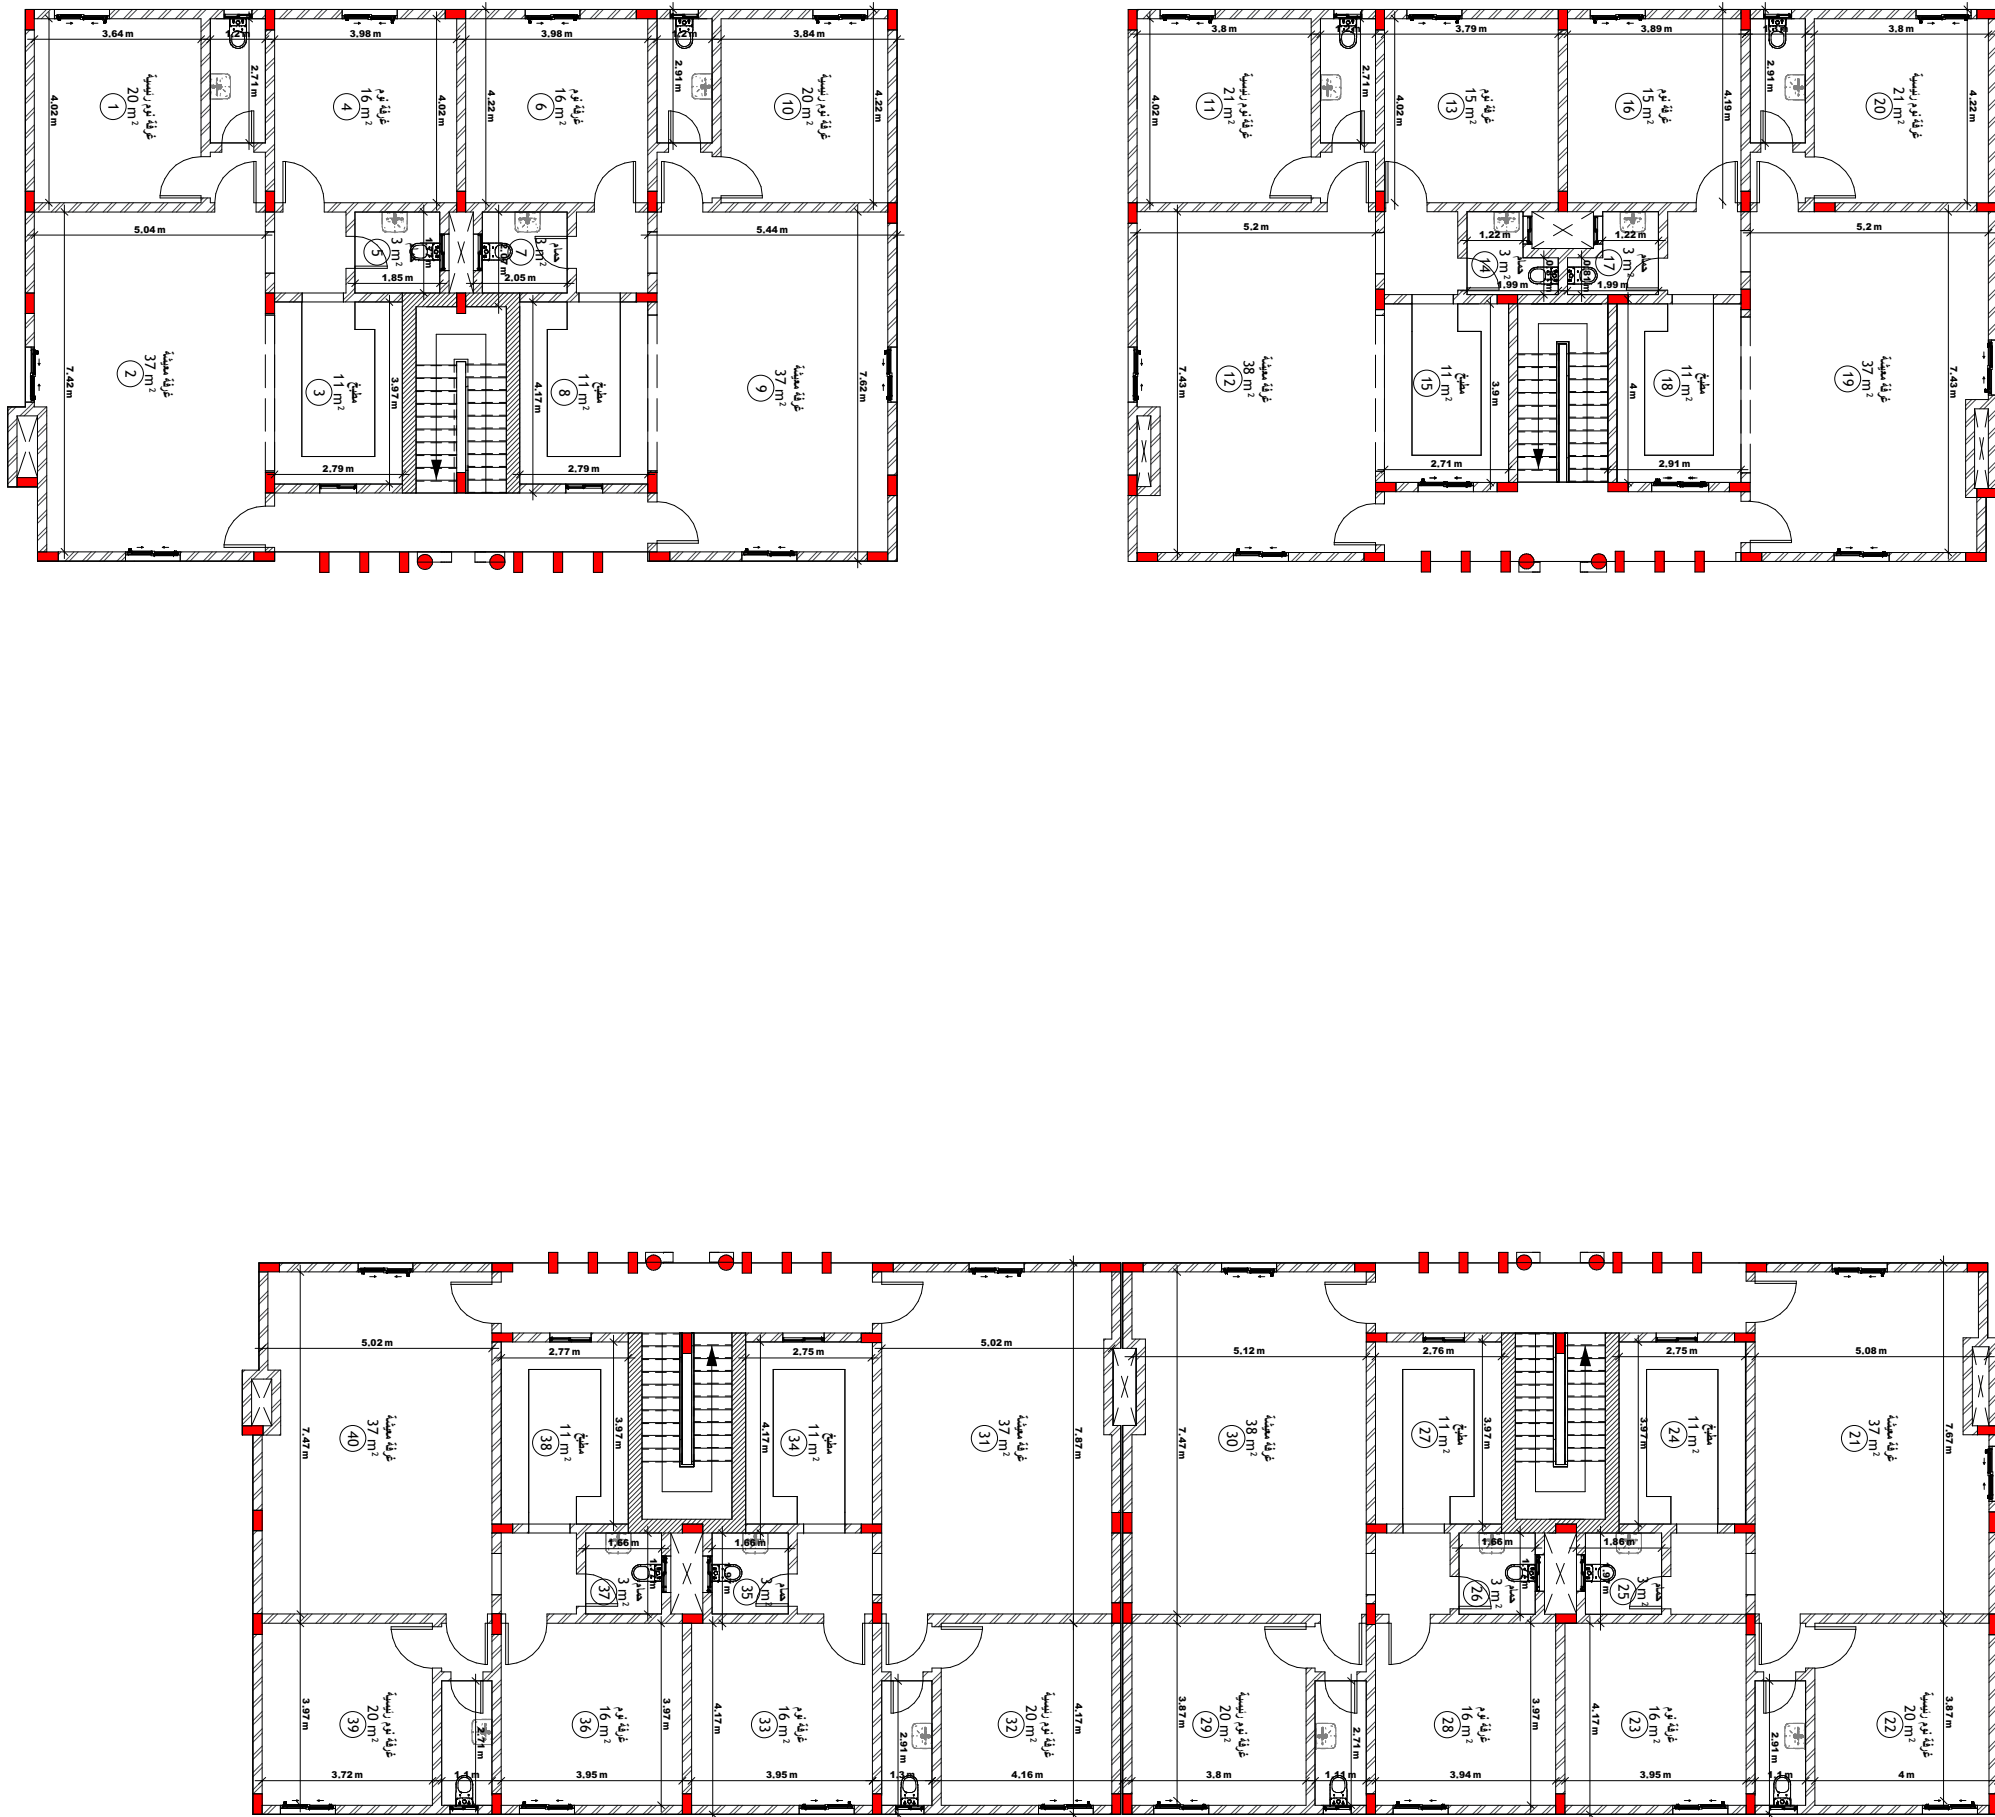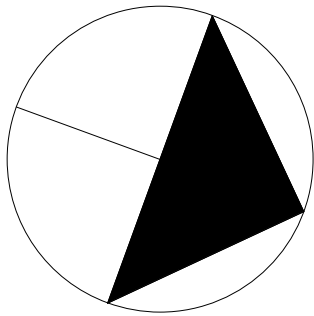



PROJECT NAME	DRAWING TITLE	DESIGNED BY	DRAWING NUM.	DATE
RAWDA COMPOUND	AS BUILT FLOOR PLANS	ARC. ABDELRAHMAN	A103	10/04/25
CLINT NAME	FLOOR TITLE	CHECKED BY	APPROVED BY	SCALE
ABNAA EL ZEEYIEB	FIRST FLOOR PLAN	ARC. OSAMA & ARC. FAISAL	ARC. YOUSEF	1 : 150

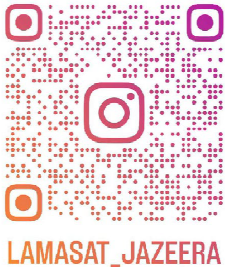


LAMASAT_JAZEERA

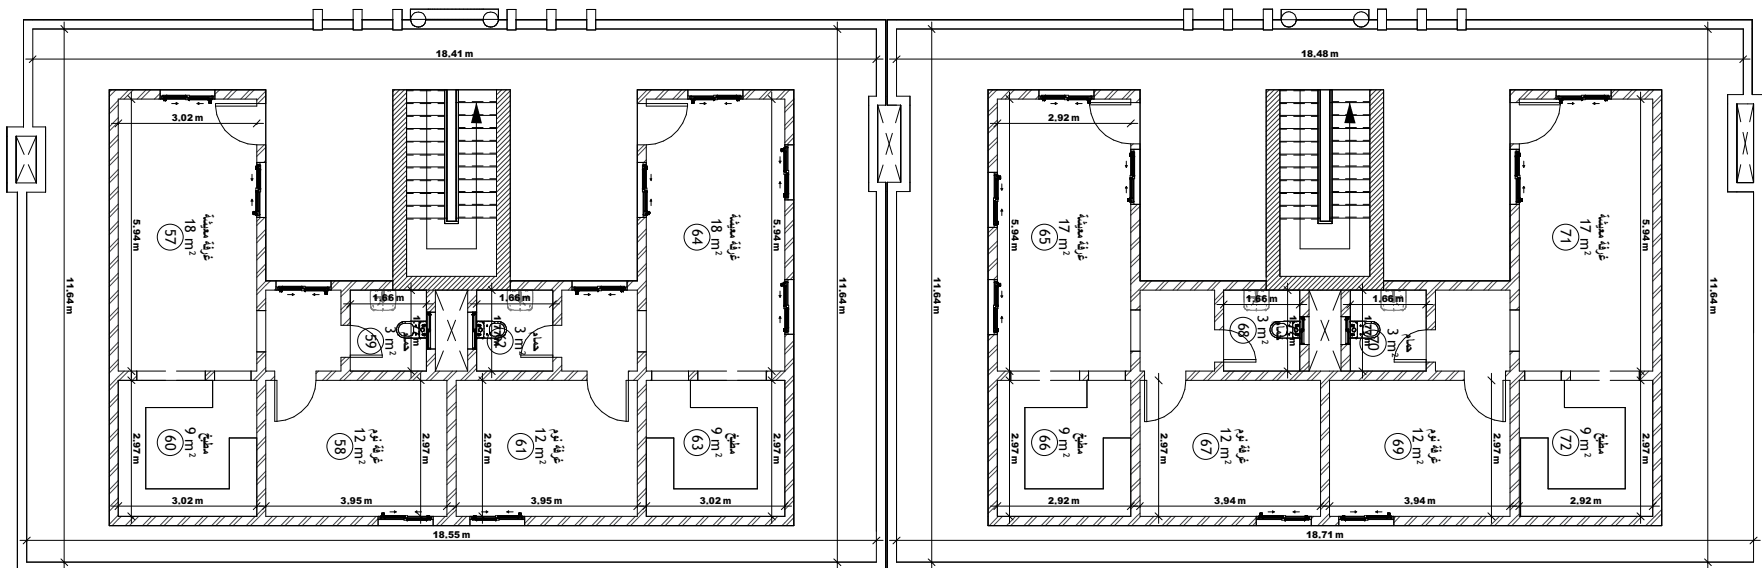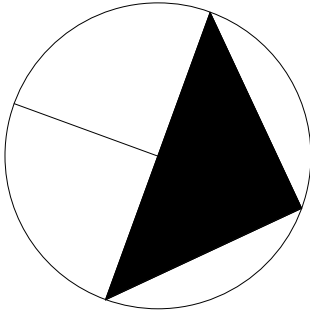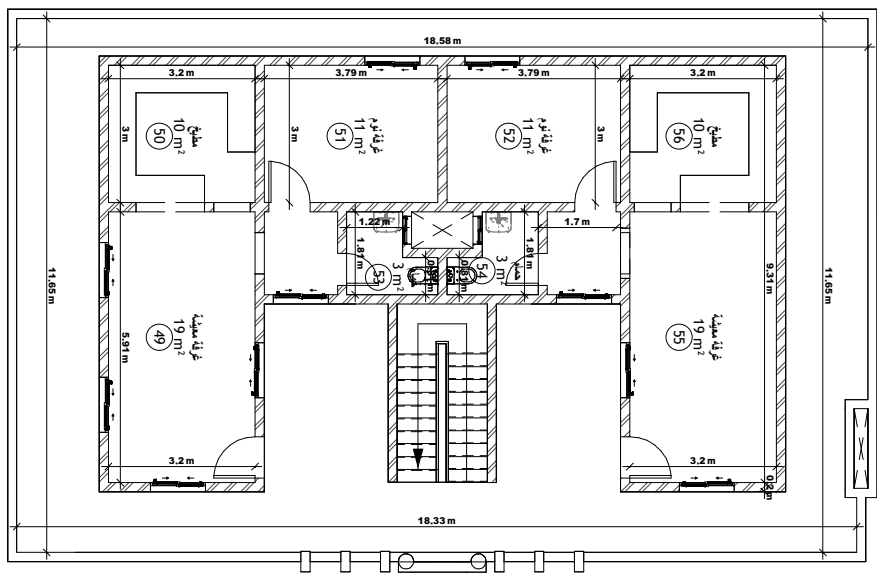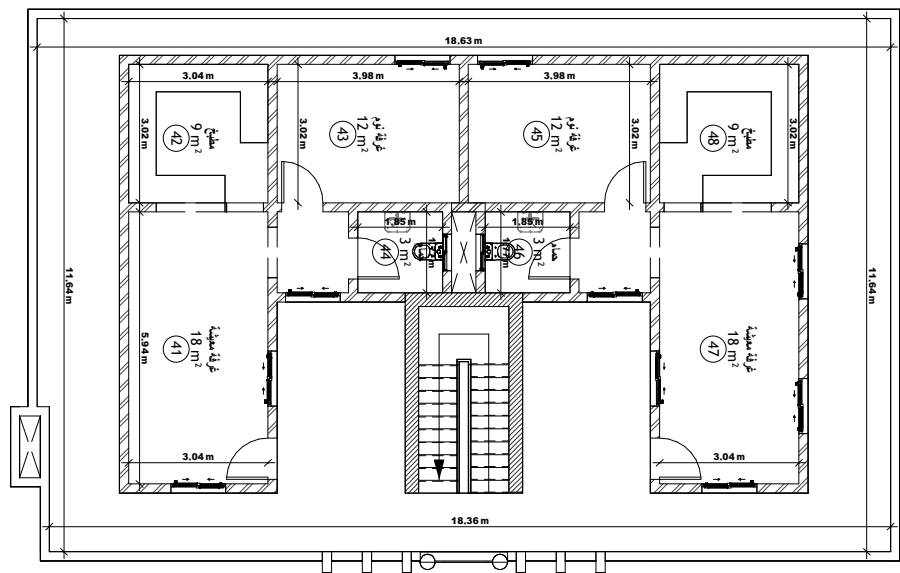


	PROJECT NAME	DRAWING TITLE	DESIGNED BY	DRAWING NUM.	DATE		
	RAWDA COMPOUND	AS BUILT FLOOR PLANS	ARC. ABDELRAHMAN	A104	10/04/25		
	CLINT NAME	FLOOR TITLE	CHECKED BY	APPROVED BY	SCALE		
	ABNAA EL ZEEYIEB	ROOF FLOOR PLAN	ARC. OSAMA & ARC. FAISAL	ARC. YOUSEF	1 : 150		

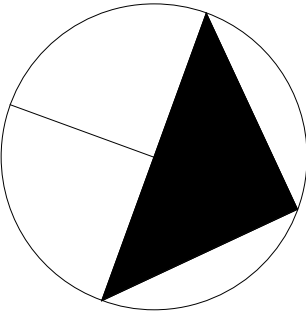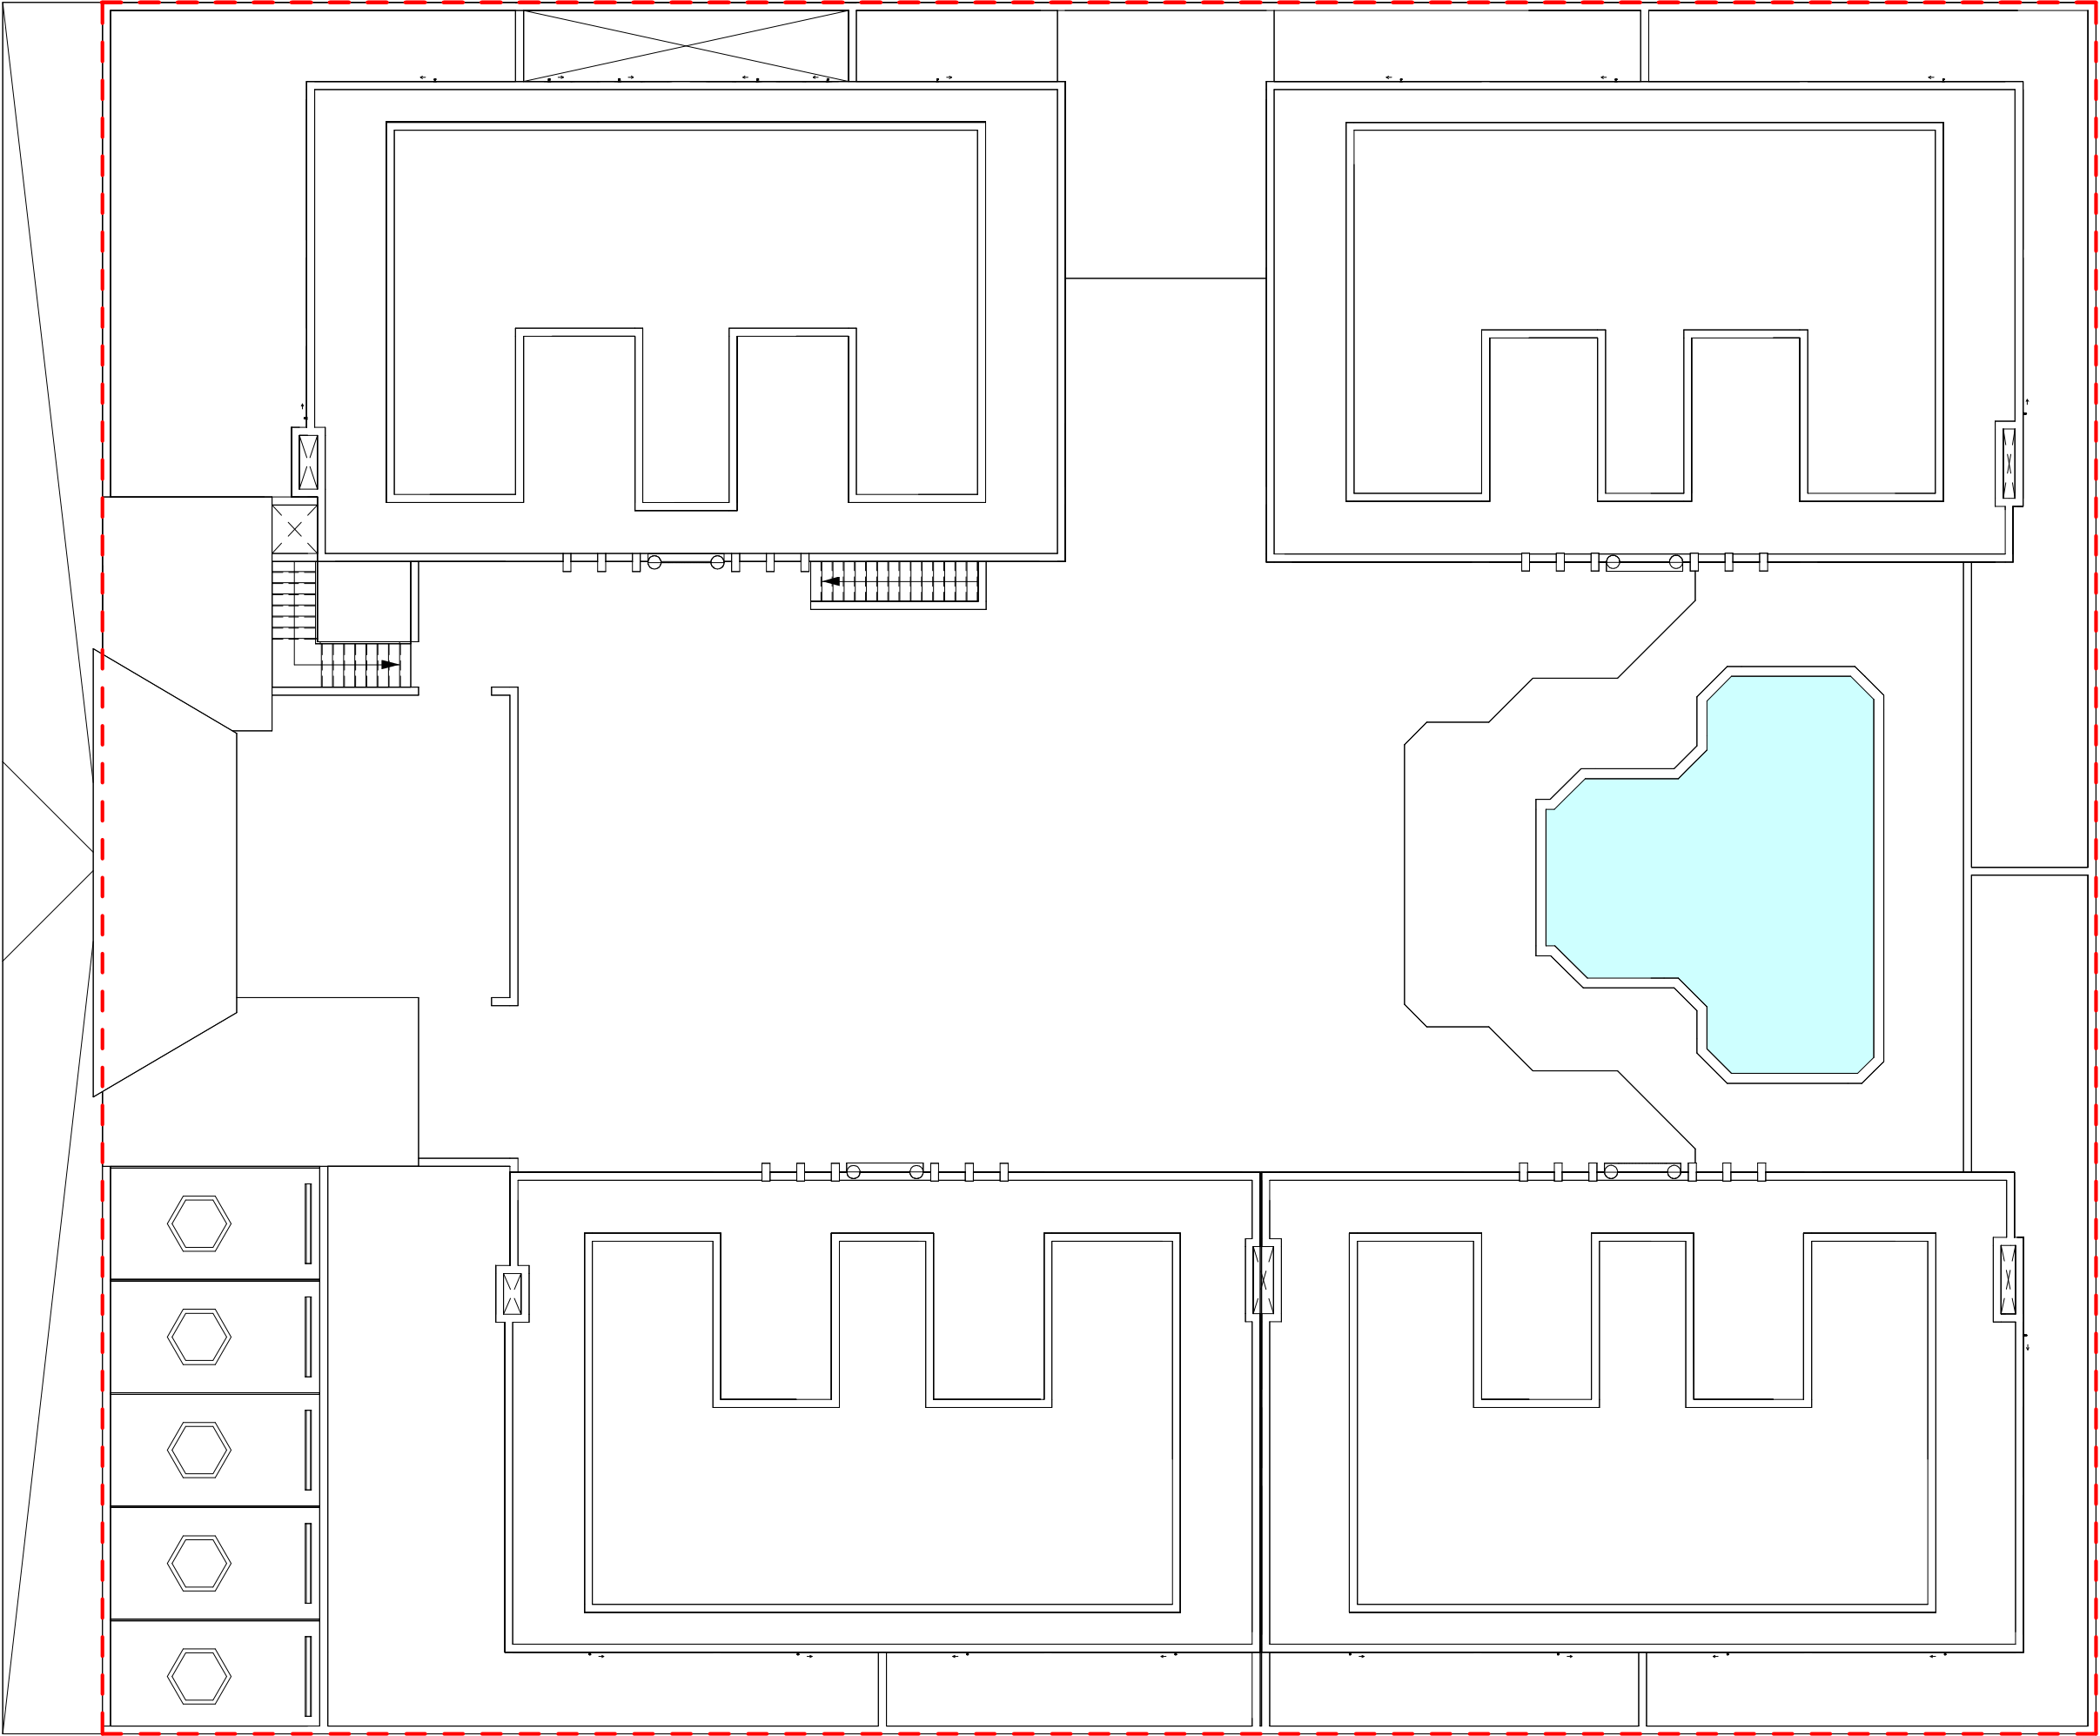


	PROJECT NAME	DRAWING TITLE	DESIGNED BY	DRAWING NUM.	DATE		
	RAWDA COMPOUND	AS BUILT FLOOR PLANS	ARC. ABDELRAHMAN	A105	10/04/25		
	CLINT NAME	FLOOR TITLE	CHECKED BY	APPROVED BY	SCALE		
	ABNAA EL ZEEYIEB	SITE PLAN	ARC. OSAMA & ARC. FAISAL	ARC. YOUSEF	1 : 150		

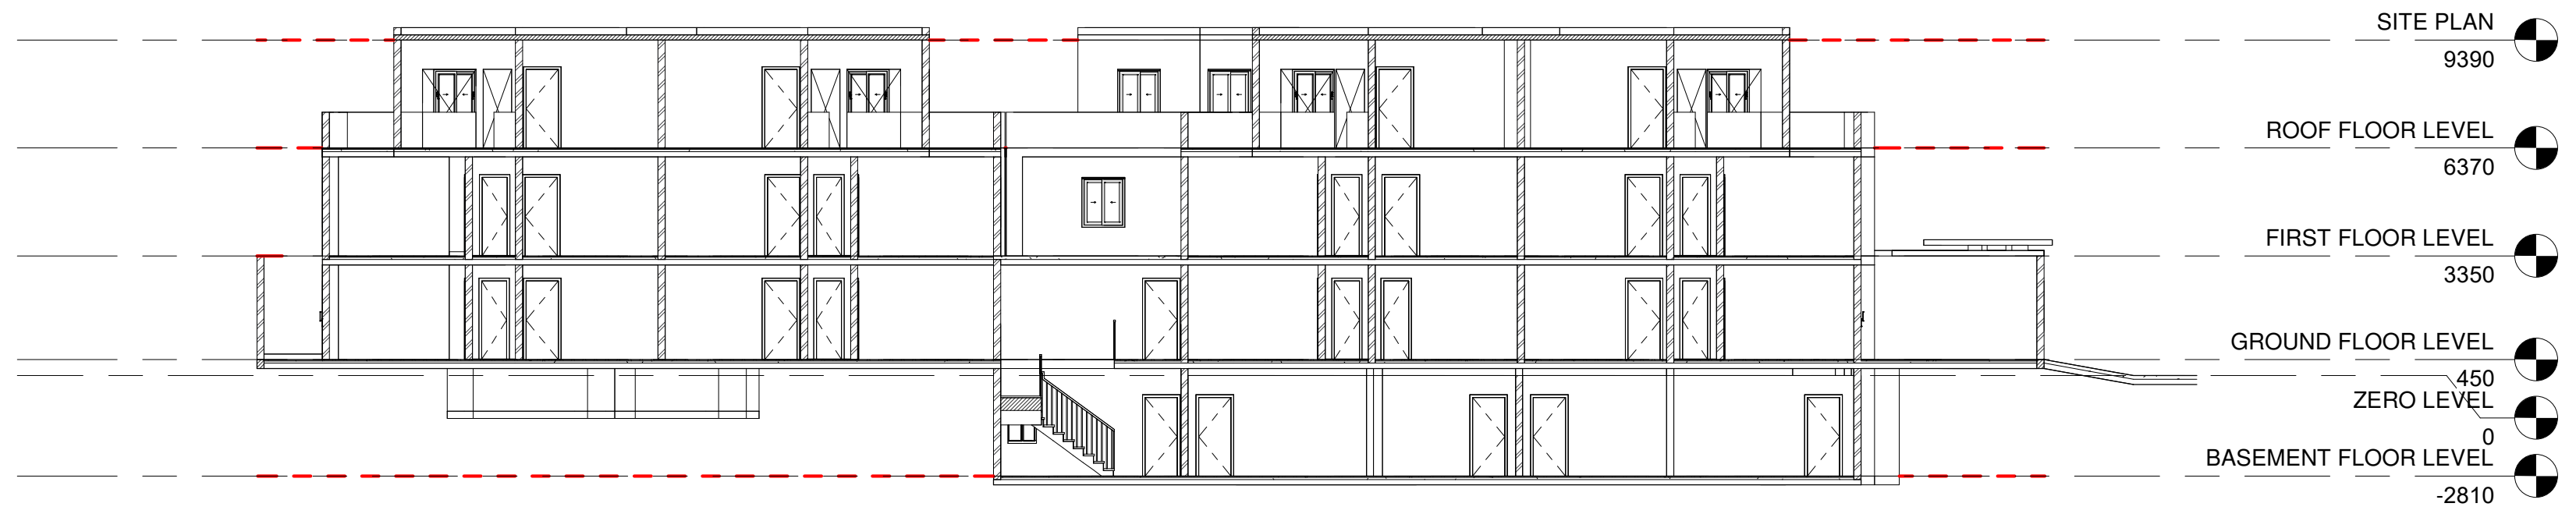


1 SECTION 1-1
1 : 150

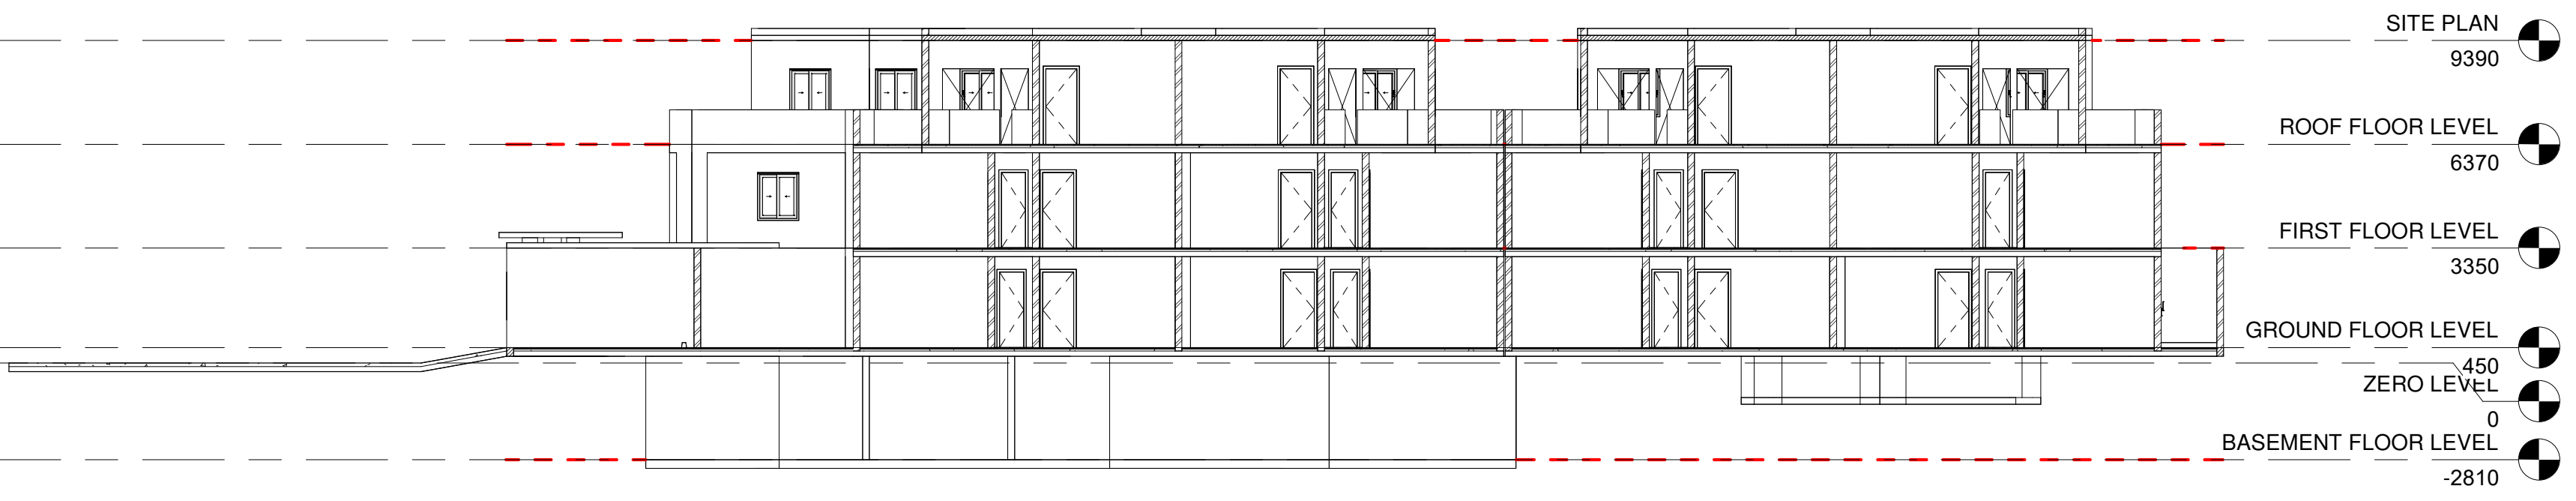

2 SECTION 2-2
1 : 150

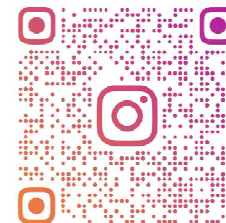
	PROJECT NAME	DRAWING TITLE	DESIGNED BY	DRAWING NUM.	DATE		 LAMASAT_JAZEERA
	RAWDA COMPOUND	AS BUILT FLOOR PLANS	ARC. ABDELRAHMAN	A106	10/04/25		
	CLINT NAME	FLOOR TITLE	CHECKED BY	APPROVED BY	SCALE		
	ABNAA EL ZEEYIEB	SECTIONS	ARC. OSAMA & ARC. FAISAL	ARC. YOUSEF	1 : 150		

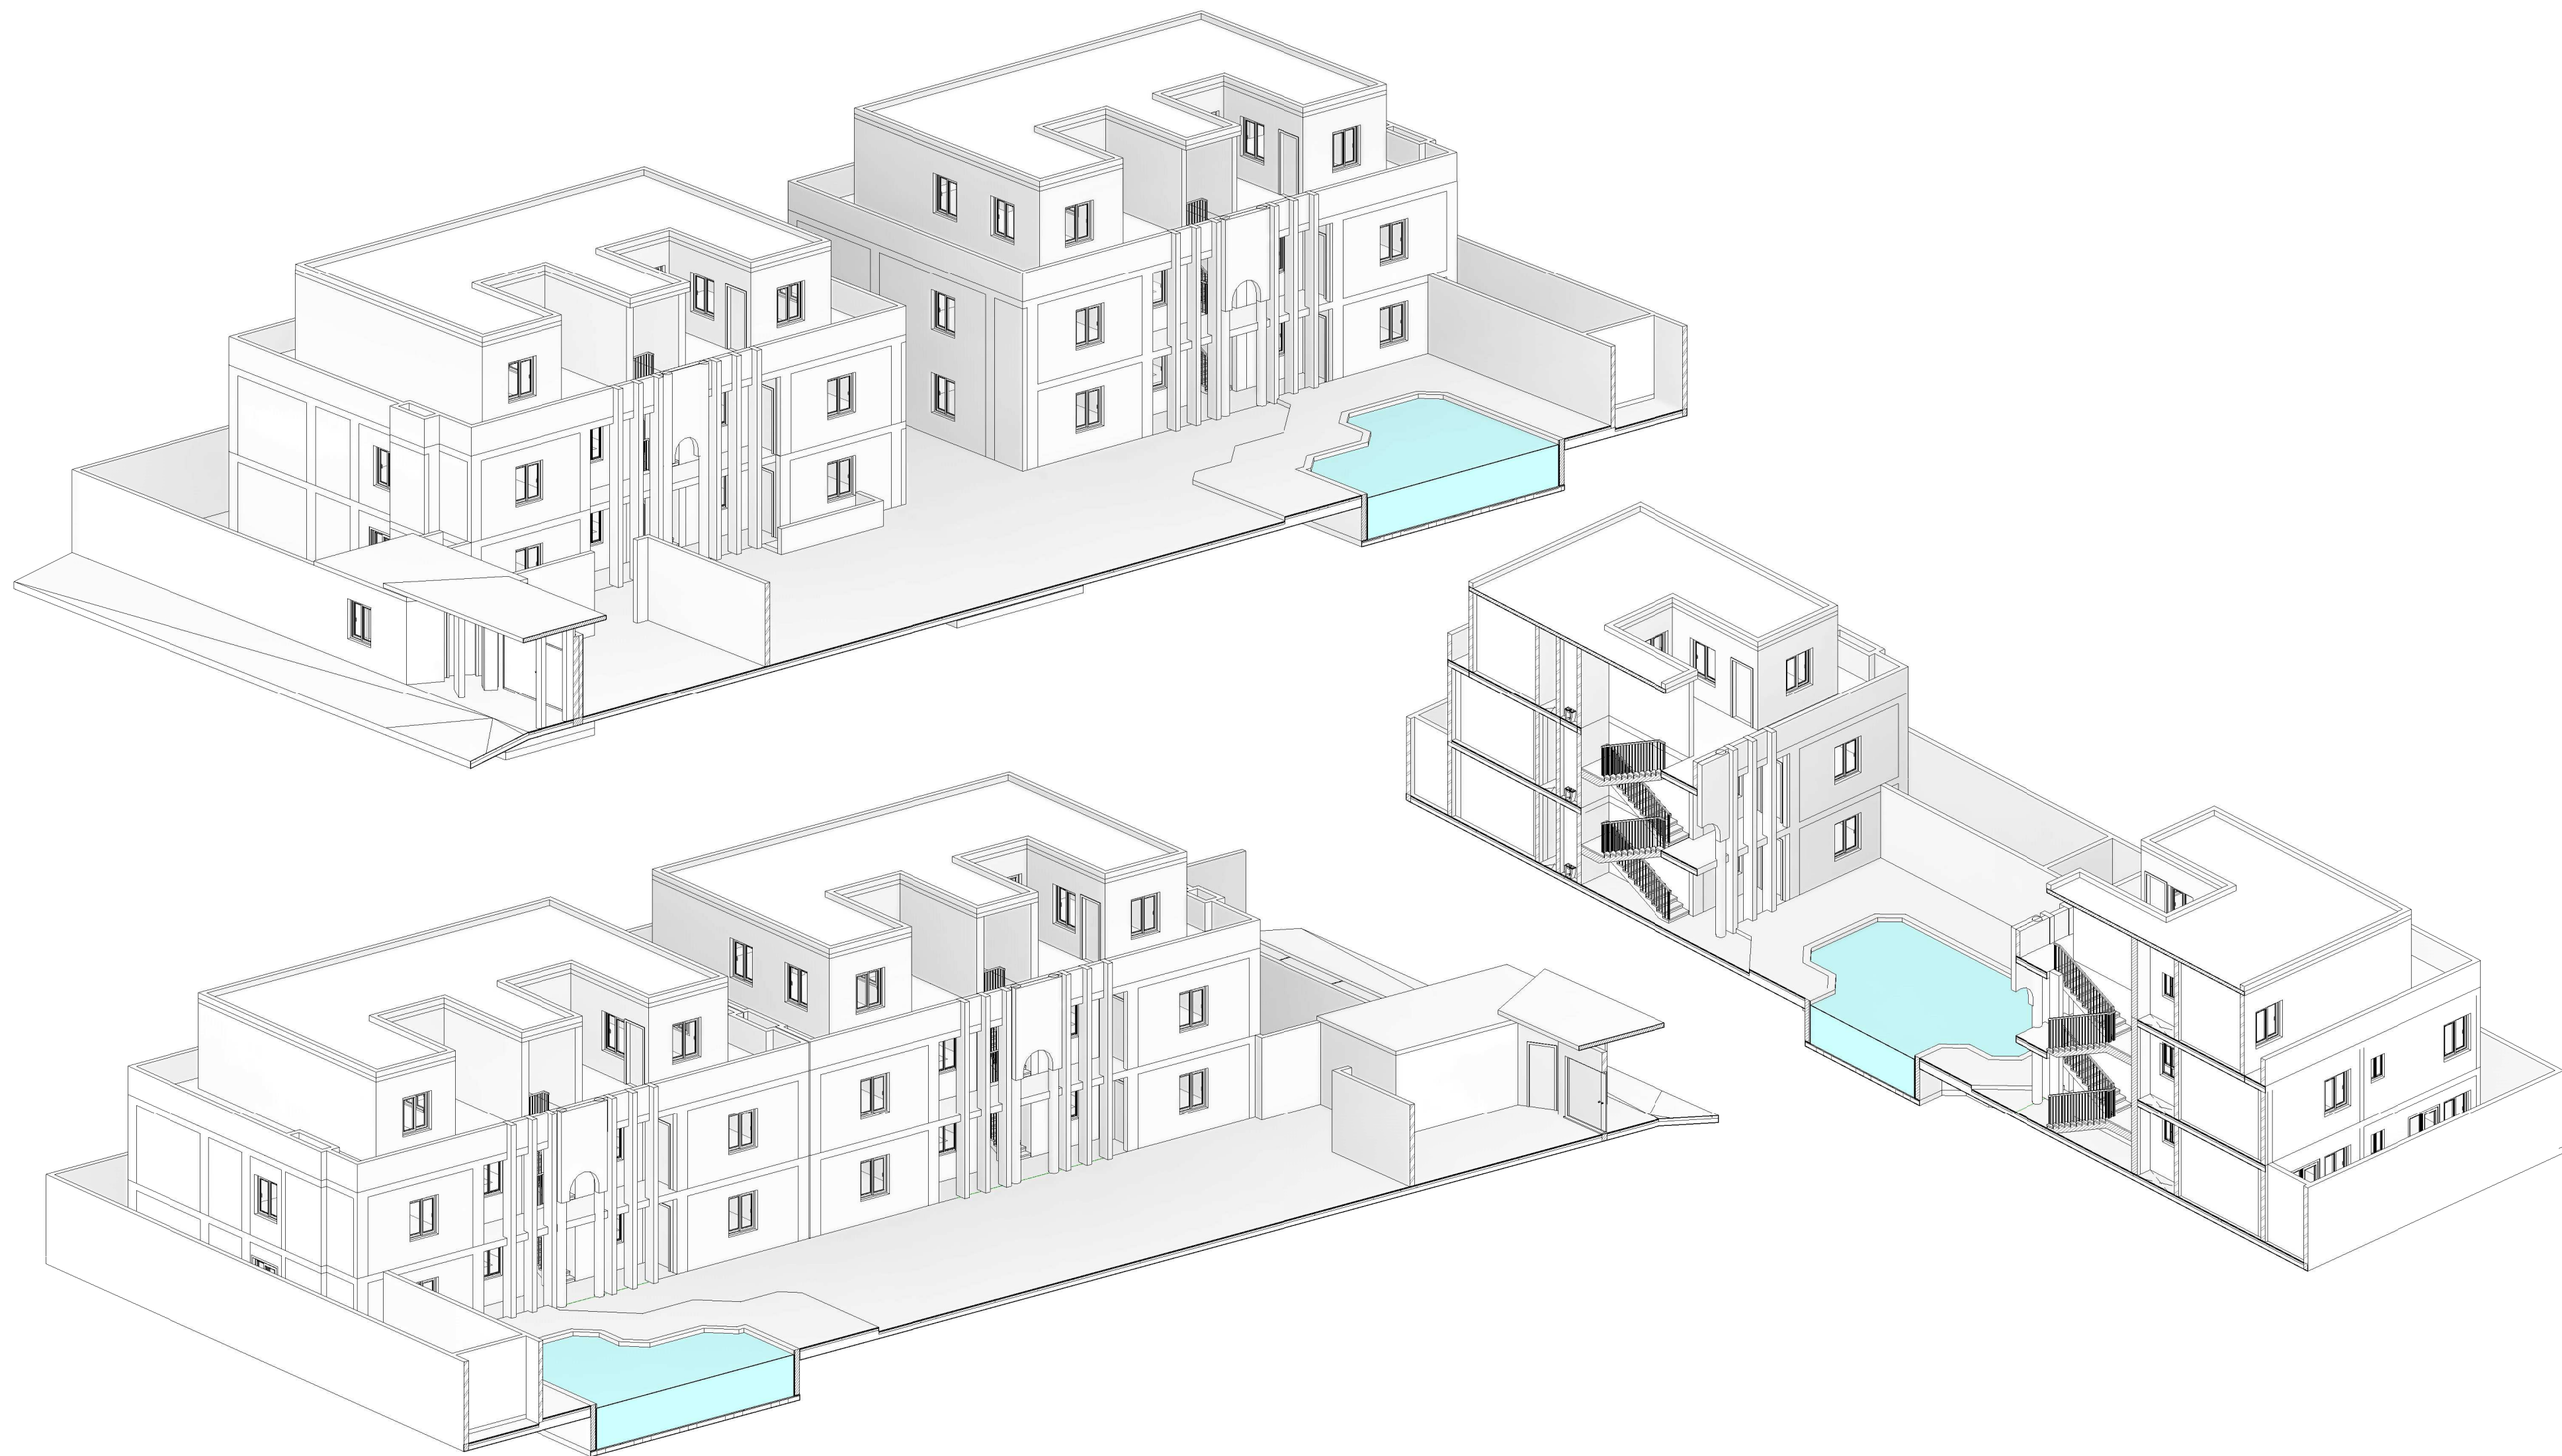



	PROJECT NAME	DRAWING TITLE	DESIGNED BY	DRAWING NUM.	DATE		
	RAWDA COMPOUND	AS BUILT FLOOR PLANS	ARC. ABDELRAHMAN	A107	10/04/25		
	CLINT NAME	FLOOR TITLE	CHECKED BY	APPROVED BY	SCALE		
	ABNAA EL ZEEYIEB	3D SECTION VIEWS	ARC. OSAMA & ARC. FAISAL	ARC. YOUSEF			



	PROJECT NAME	DRAWING TITLE	DESIGNED BY	DRAWING NUM.	DATE		
	RAWDA COMPOUND	AS BUILT FLOOR PLANS	ARC. ABDELRAHMAN	A108	10/04/25		
	CLINT NAME	FLOOR TITLE	CHECKED BY	APPROVED BY	SCALE		
	ABNAA EL ZEEYIEB	3D PRESPECTIVE 1	ARC. OSAMA & ARC. FAISAL	ARC. YOUSEF			

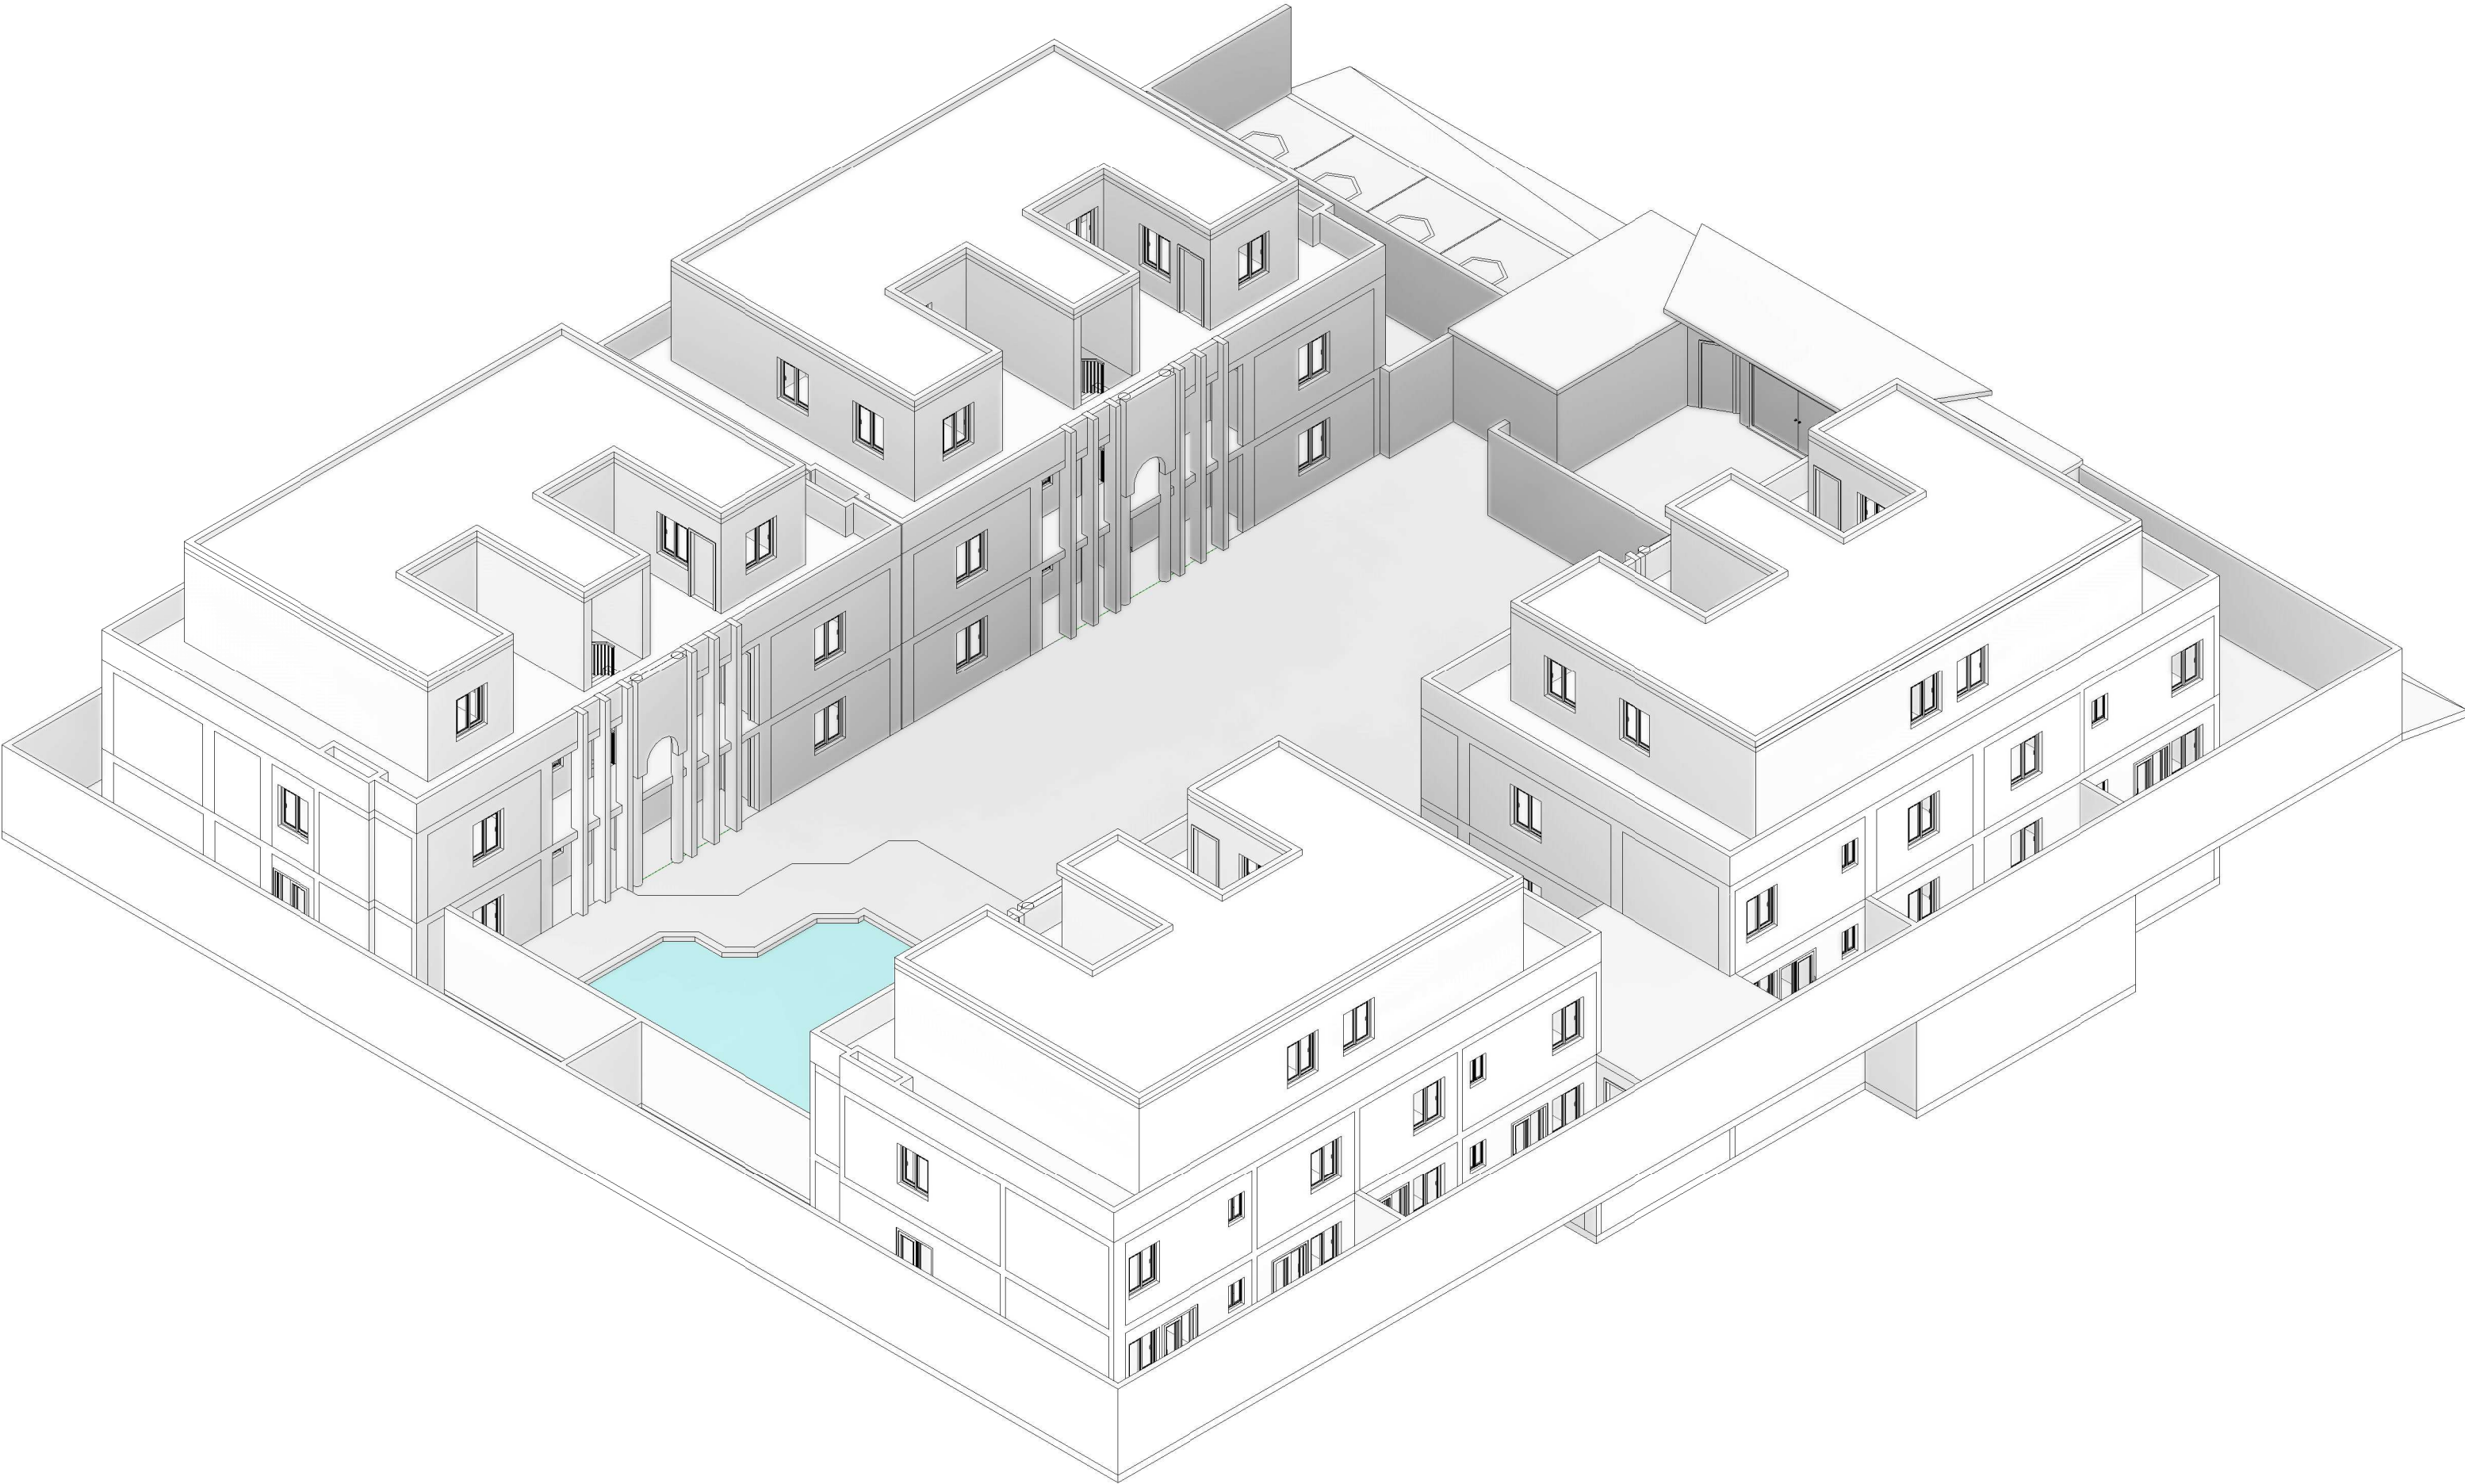

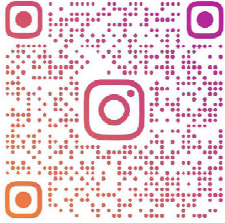	PROJECT NAME	DRAWING TITLE	DESIGNED BY	DRAWING NUM.	DATE		 LAMASAT_JAZEERA
	RAWDA COMPOUND	AS BUILT FLOOR PLANS	ARC. ABDELRAHMAN	A109	10/04/25		
	CLINT NAME	FLOOR TITLE	CHECKED BY	APPROVED BY	SCALE		
	ABNAA EL ZEEYIEB	3D PRESPECTIVE 2	ARC. OSAMA & ARC. FAISAL	ARC. YOUSEF			

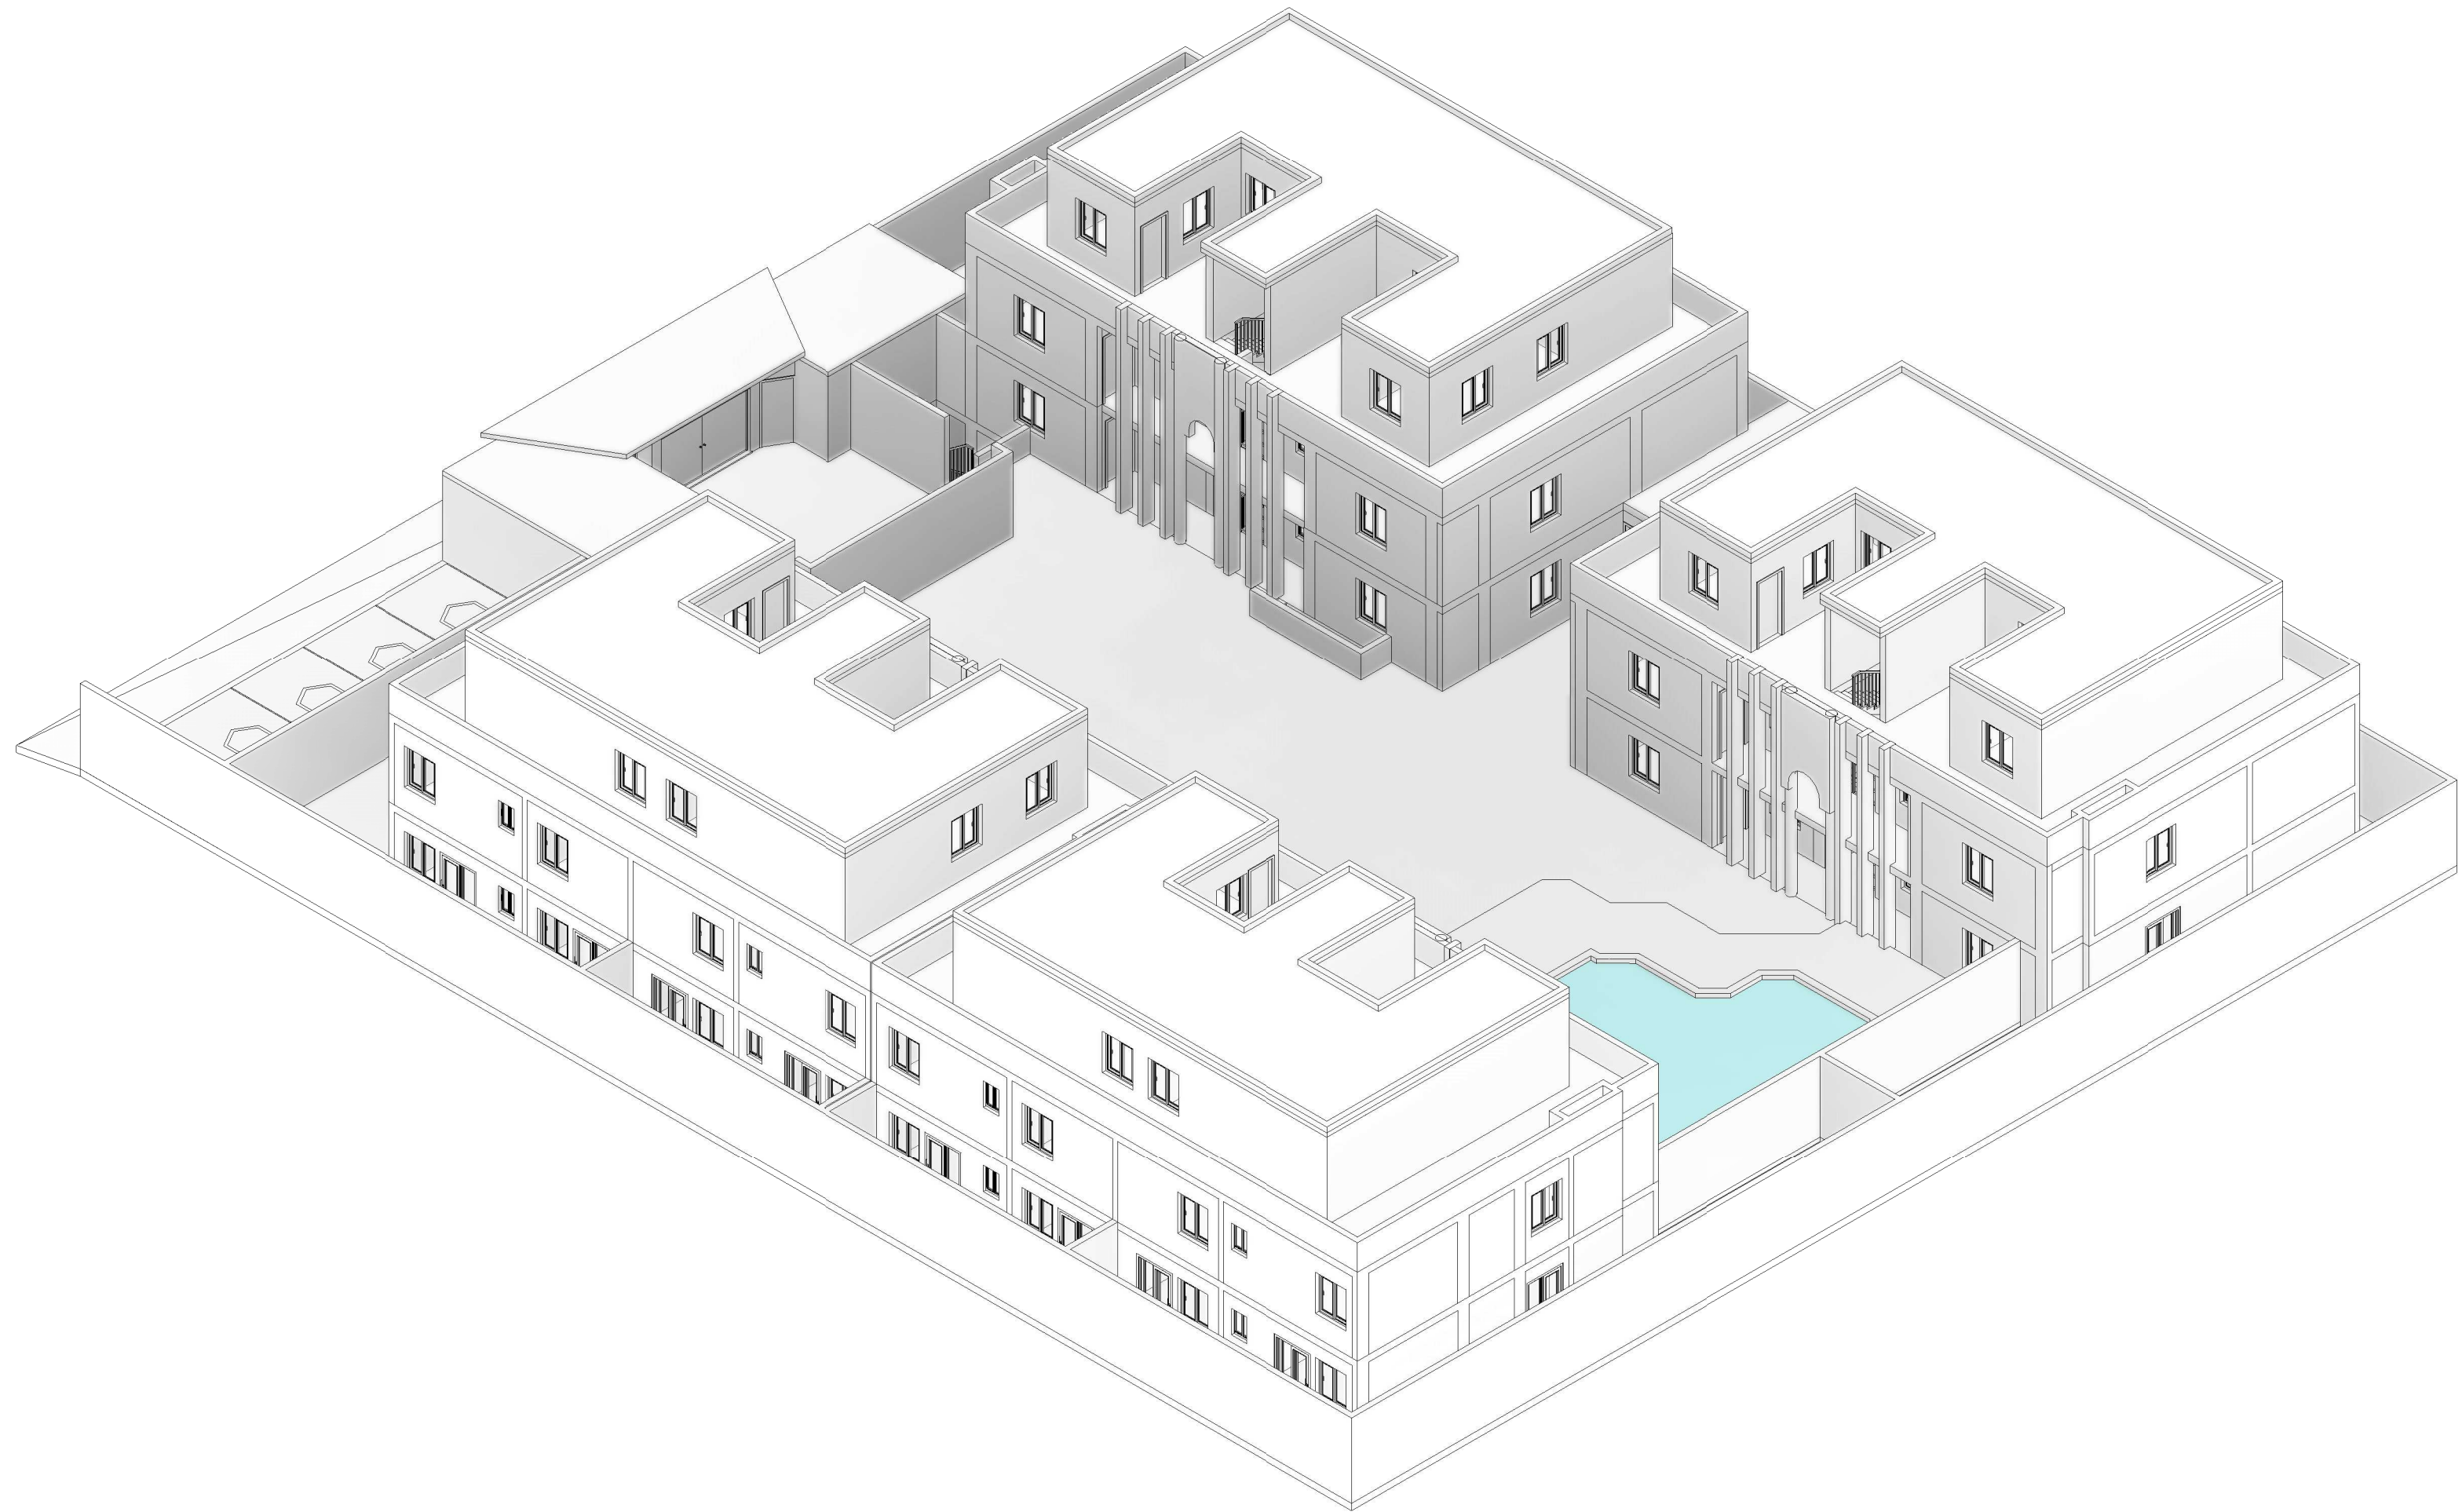


1²




PROJECT NAME	DRAWING TITLE	DESIGNED BY	DRAWING NUM.	DATE		
RAWDA COMPOUND	AS BUILT FLOOR PLANS	ARC. ABDELRAHMAN	A110	10/04/25		
CLINT NAME	FLOOR TITLE	CHECKED BY	APPROVED BY	SCALE		
ABNAA EL ZEEYIEB	3D PRESPECTIVE 3	ARC. OSAMA & ARC. FAISAL	ARC. YOUSEF			



	PROJECT NAME	DRAWING TITLE	DESIGNED BY	DRAWING NUM.	DATE		
	RAWDA COMPOUND	AS BUILT FLOOR PLANS	ARC. ABDELRAHMAN	A111	10/04/25		
	CLINT NAME	FLOOR TITLE	CHECKED BY	APPROVED BY	SCALE		
	ABNAA EL ZEEYIEB	3D PRESPECTIVE 4	ARC. OSAMA & ARC. FAISAL	ARC. YOUSEF			

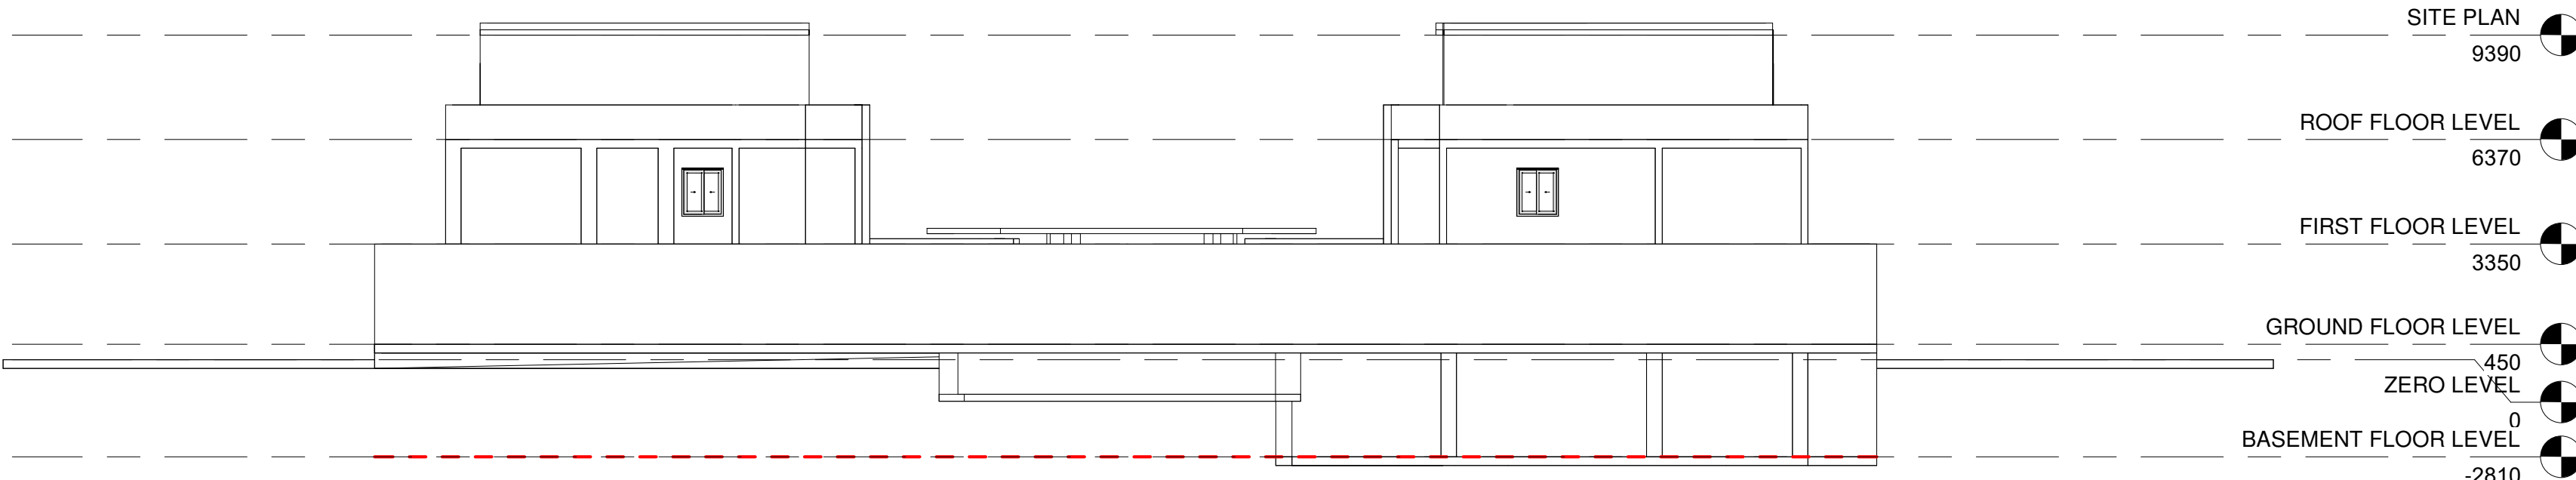


1 North
1 : 150

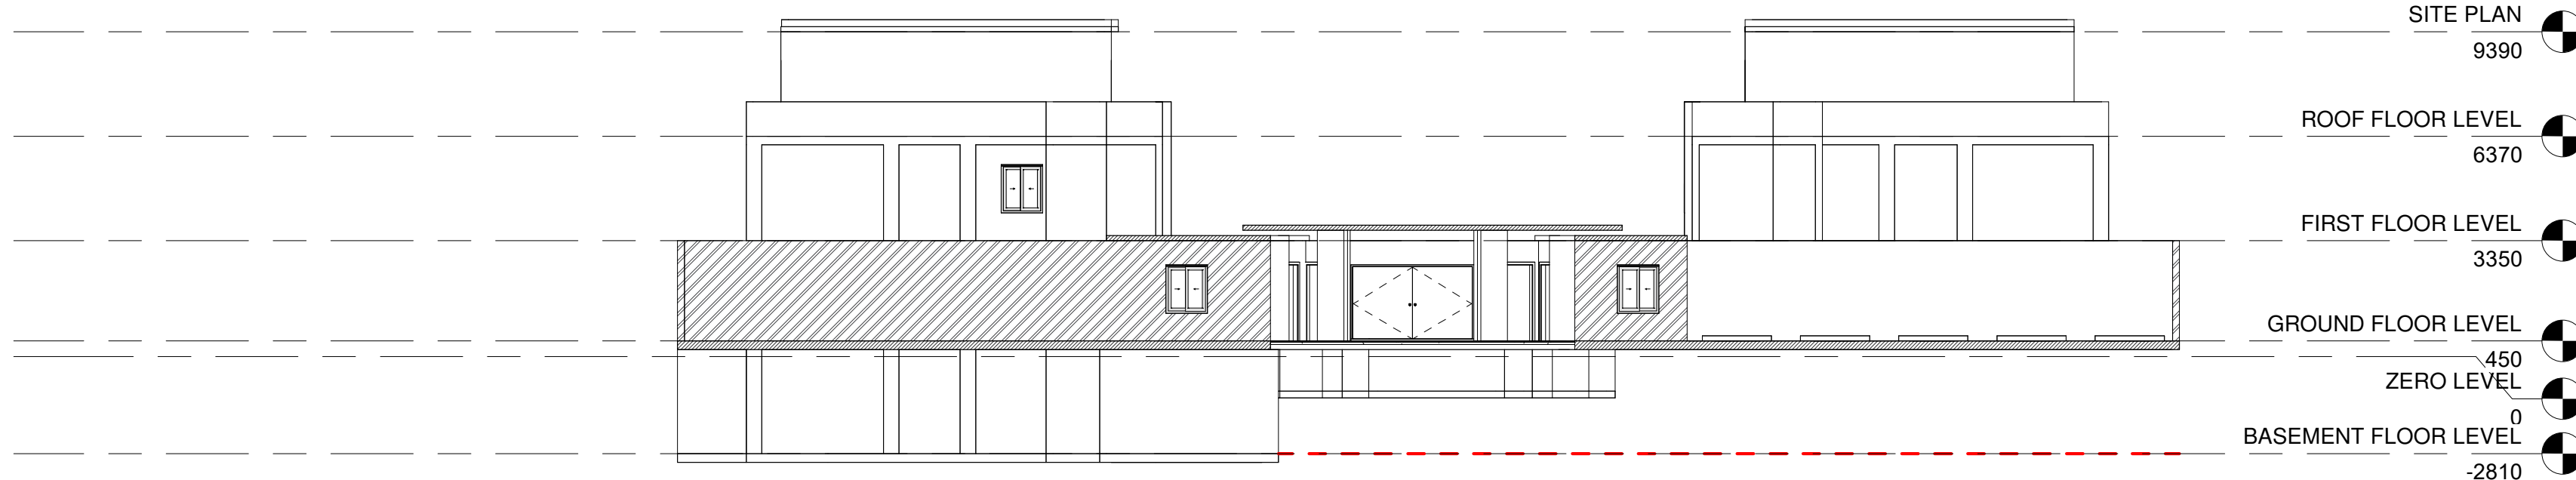


2 South
1 : 150


	PROJECT NAME	DRAWING TITLE	DESIGNED BY	DRAWING NUM.	DATE		
	RAWDA COMPOUND	AS BUILT FLOOR PLANS	ARC. ABDELRAHMAN	A112	10/04/25		
	CLINT NAME	FLOOR TITLE	CHECKED BY	APPROVED BY	SCALE		
	ABNAA EL ZEEYIEB	NORTH & SOUTH ELEVATIONS	ARC. OSAMA & ARC. FAISAL	ARC. YOUSEF	1 : 150		

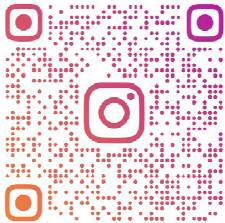


	PROJECT NAME	DRAWING TITLE	DESIGNED BY	DRAWING NUM.	DATE		 LAMASAT_JAZEERA
	RAWDA COMPOUND	AS BUILT FLOOR PLANS	ARC. ABDELRAHMAN	A113	10/04/25		
	CLINT NAME	FLOOR TITLE	CHECKED BY	APPROVED BY	SCALE		
	ABNAA EL ZEEYIEB	EAST & WEST ELEVATIONS	ARC. OSAMA & ARC. FAISAL	ARC. YOUSEF	1 : 150		

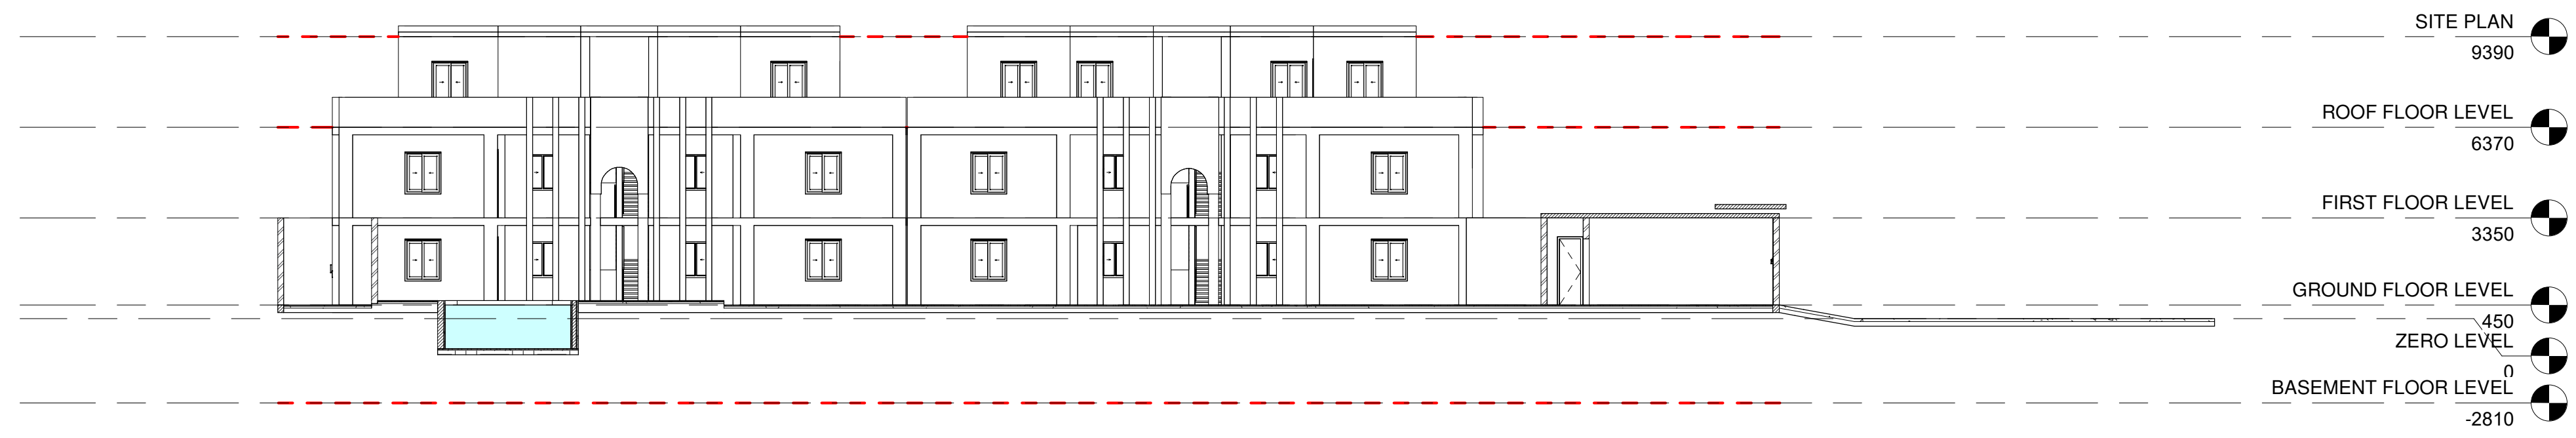

1 Elevation 1 - a
1 : 150

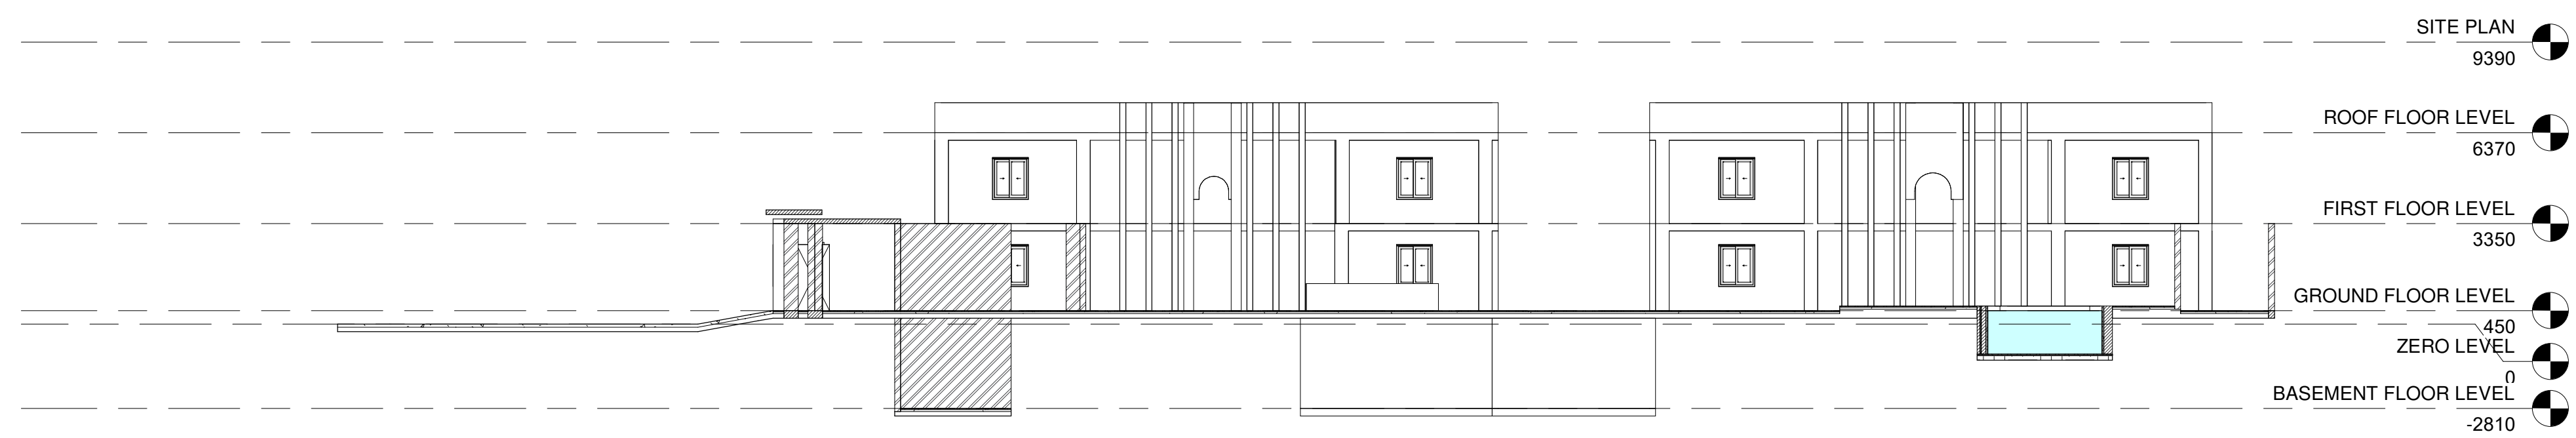

2 Elevation 2 - a
1 : 150

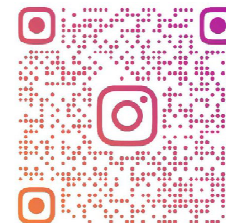	PROJECT NAME	DRAWING TITLE	DESIGNED BY	DRAWING NUM.	DATE		 LAMASAT_JAZEERA
	RAWDA COMPOUND	AS BUILT FLOOR PLANS	ARC. ABDELRAHMAN	A114	10/04/25		
	CLINT NAME	FLOOR TITLE	CHECKED BY	APPROVED BY	SCALE		
	ABNAA EL ZEEYIEB	INTERIOR ELEVATION 1 & 2	ARC. OSAMA & ARC. FAISAL	ARC. YOUSEF	1 : 150		