

Mohammed Al-Qasim


18/06/2025

D/25-39

Shop-Drawings Plans

We Create Your Dreams...

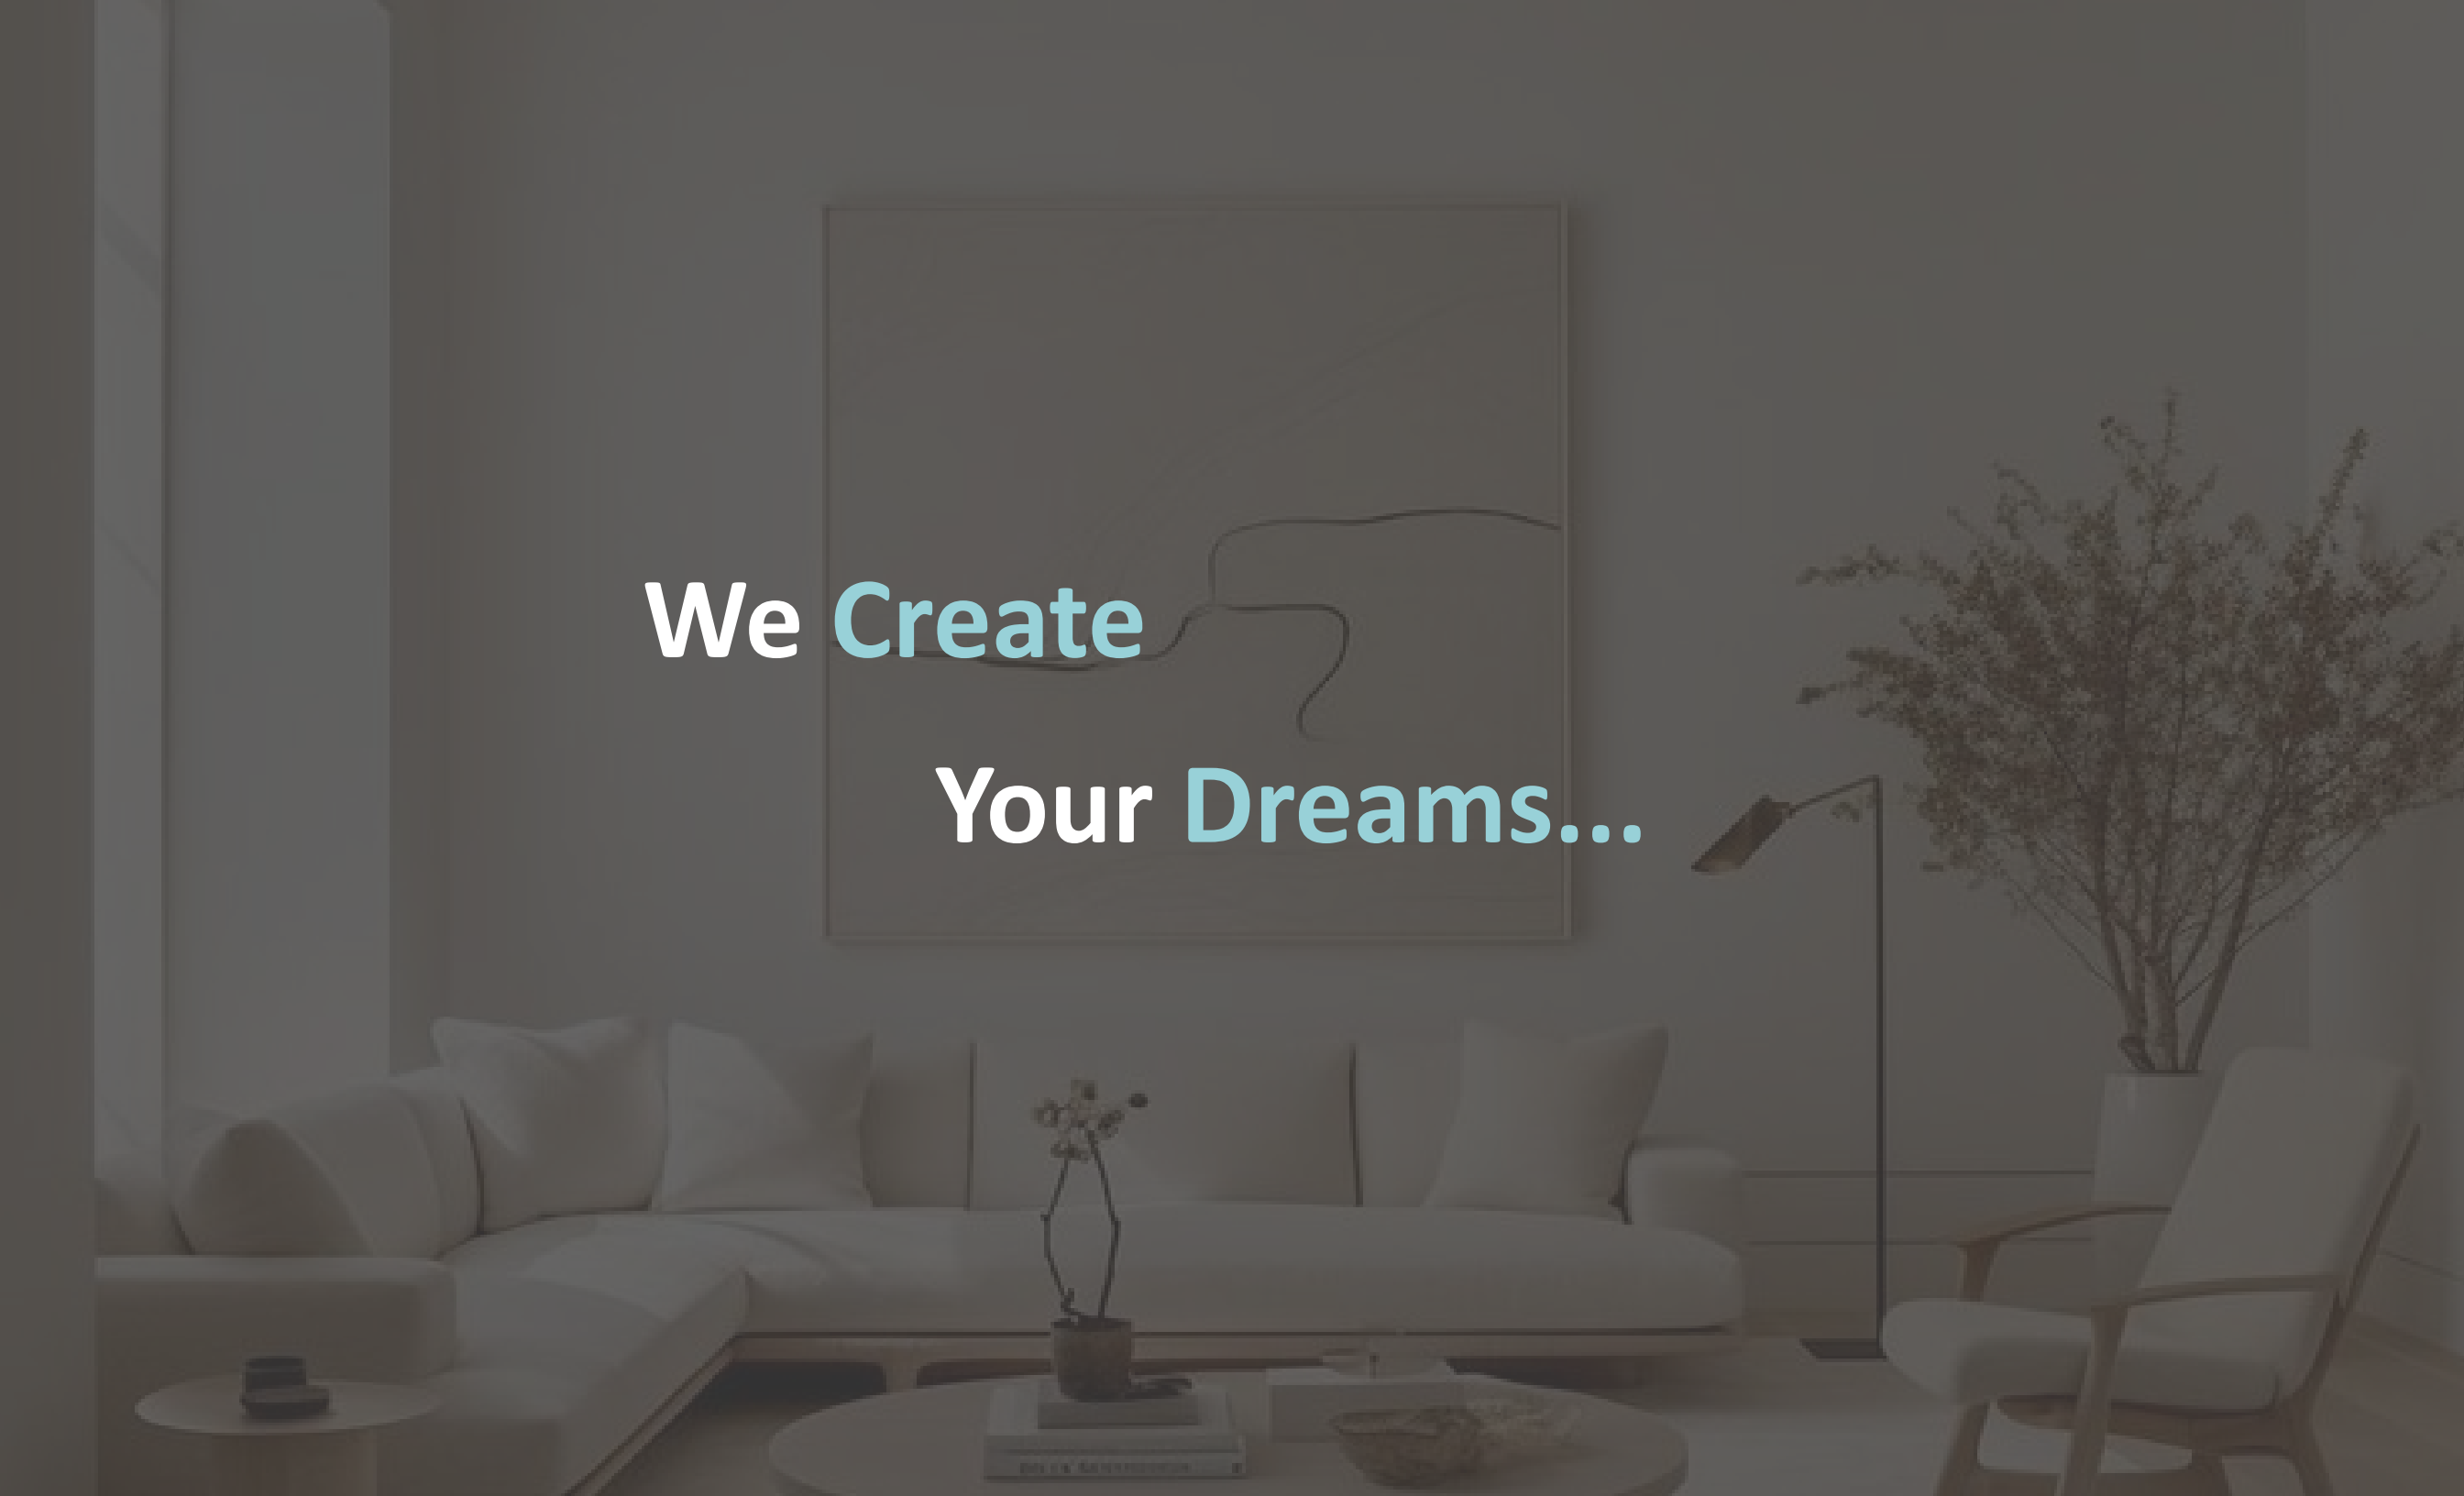

A modern living room interior with a white sofa, a large abstract painting, a floor lamp, and a potted plant. The text "We Create Your Dreams..." is overlaid on the image.

We Create
Your Dreams...


معلومات المشروع

العميل : محمد القاسم

الموقع : الرياض - روشن

تاريخ العقد : 18/02/2025

رقم المشروع : D/28-39

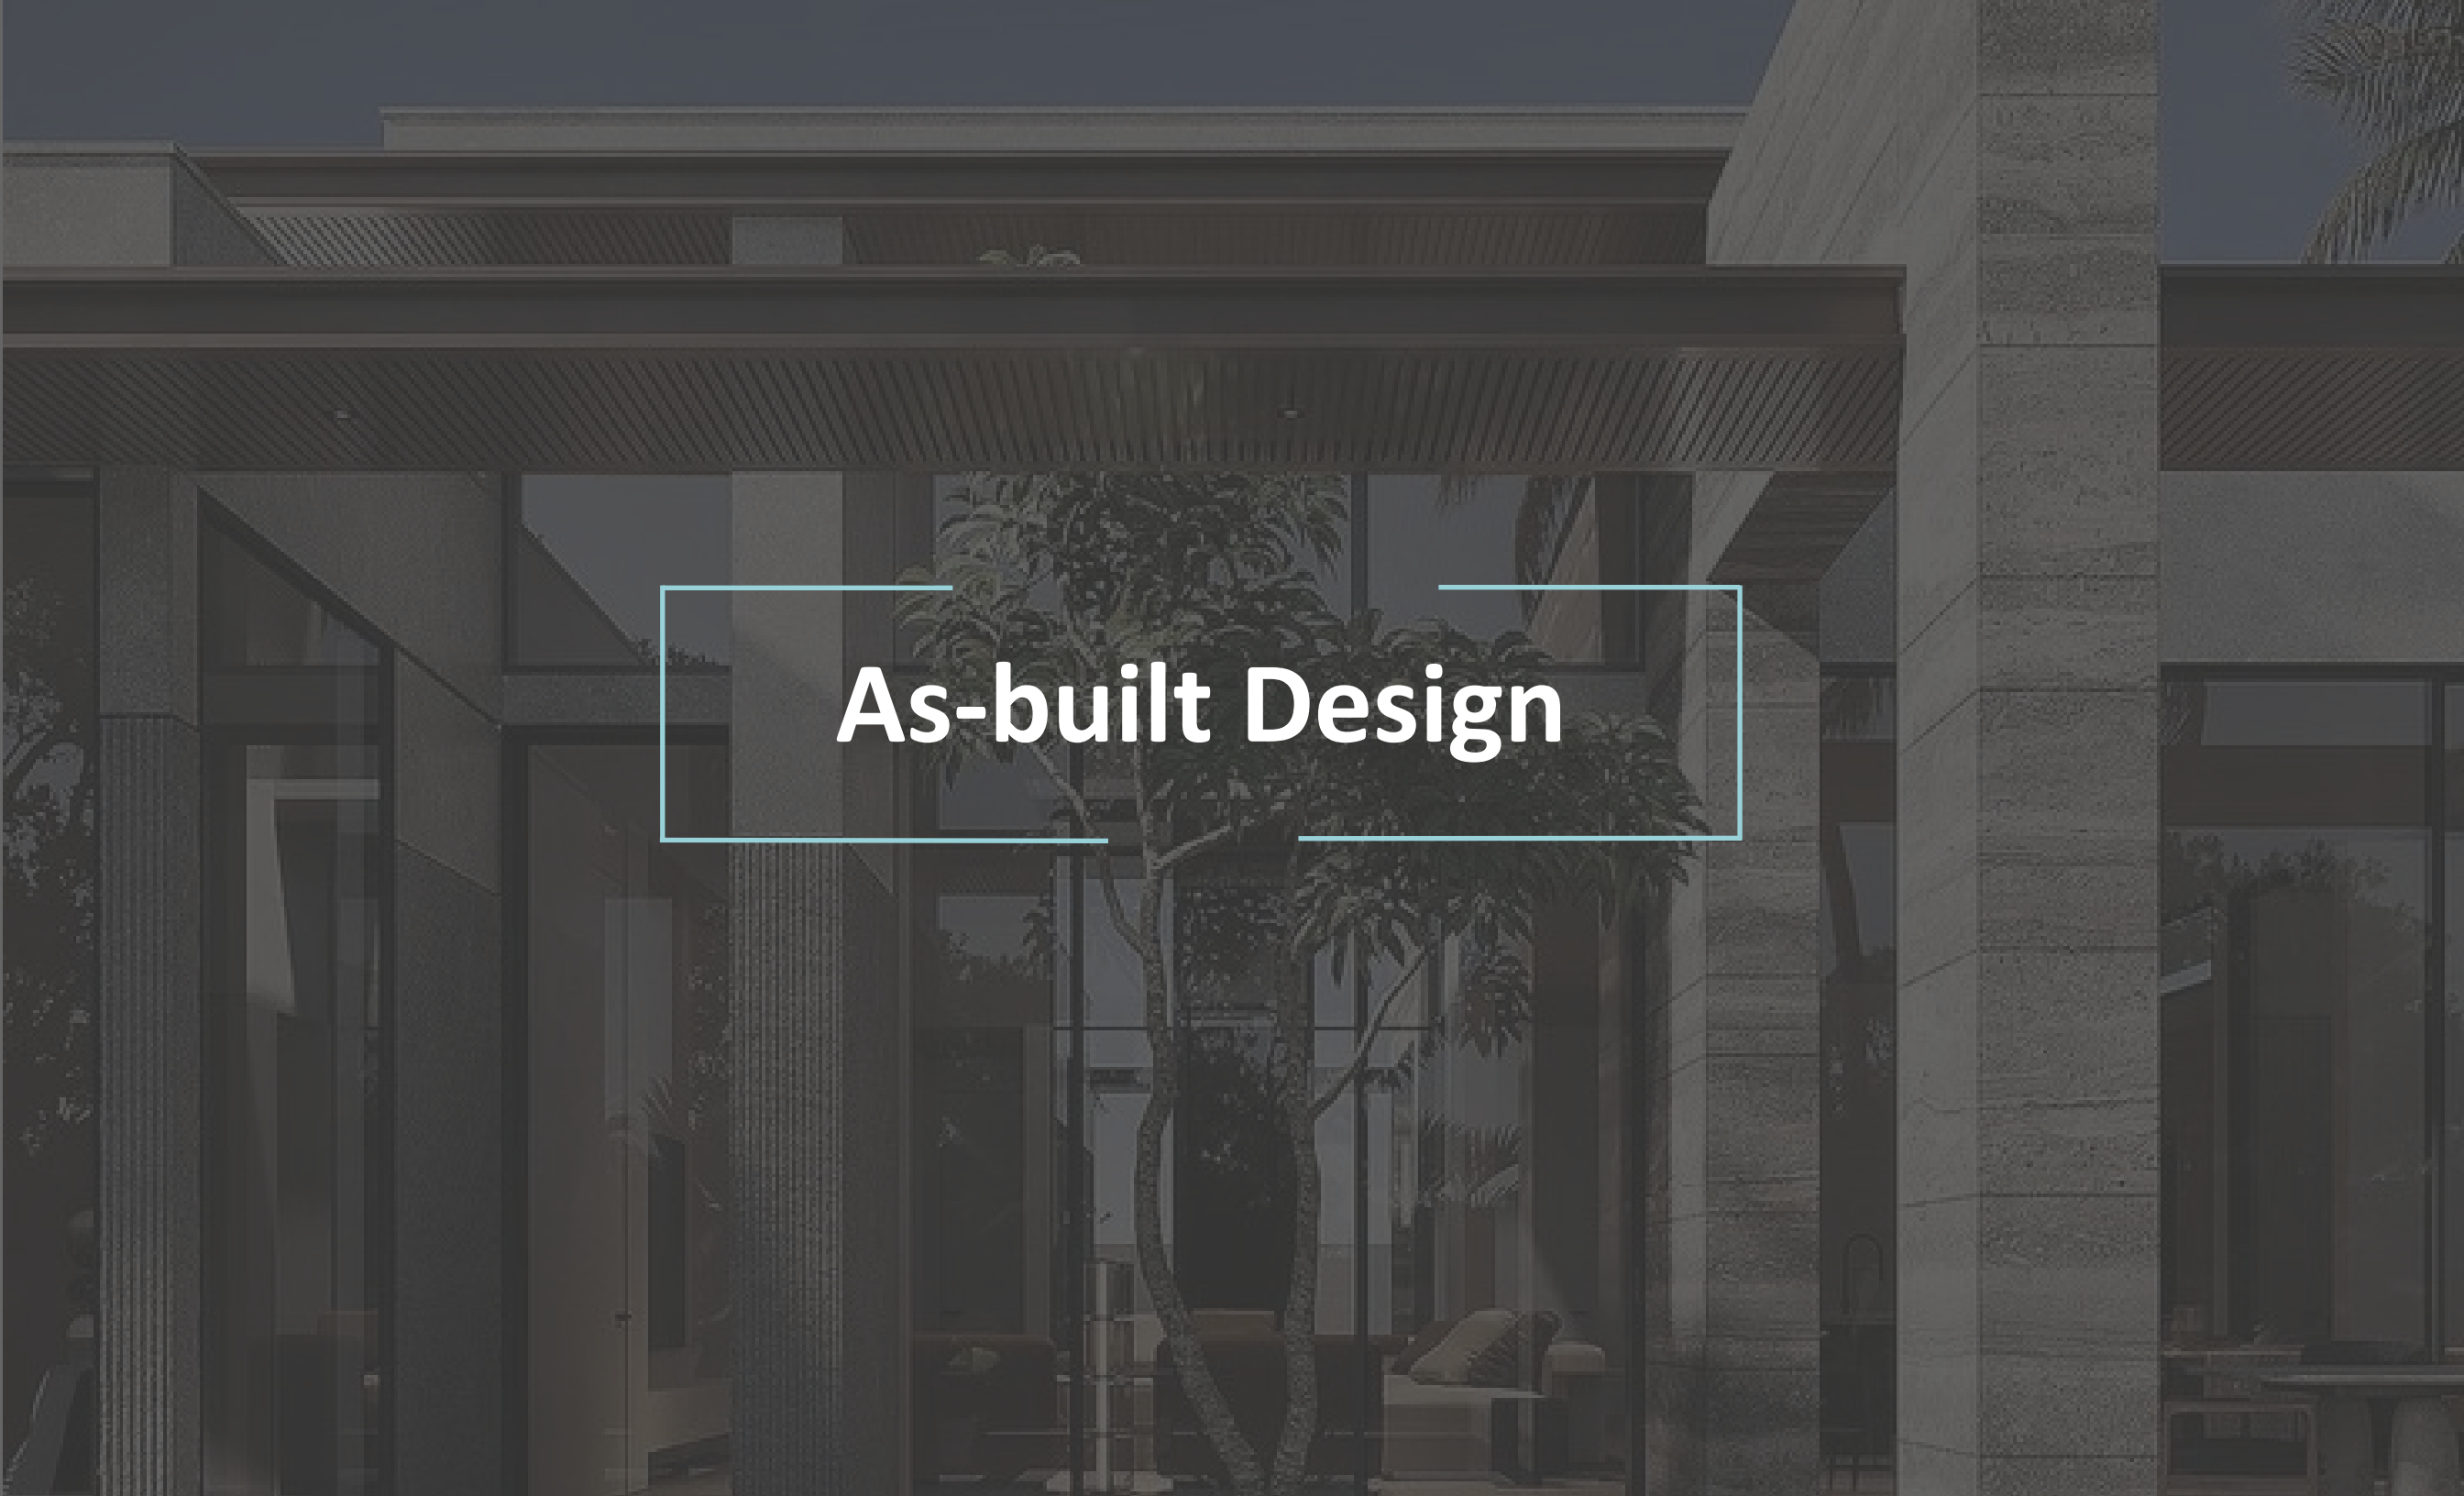A dark, atmospheric photograph of a modern building's exterior. The building features large glass windows and a prominent central tree. The scene is dimly lit, suggesting dusk or dawn. A light blue rectangular frame is superimposed over the center of the image, containing the text "As-built Design".


As-built Design

Ground Floor




First Floor

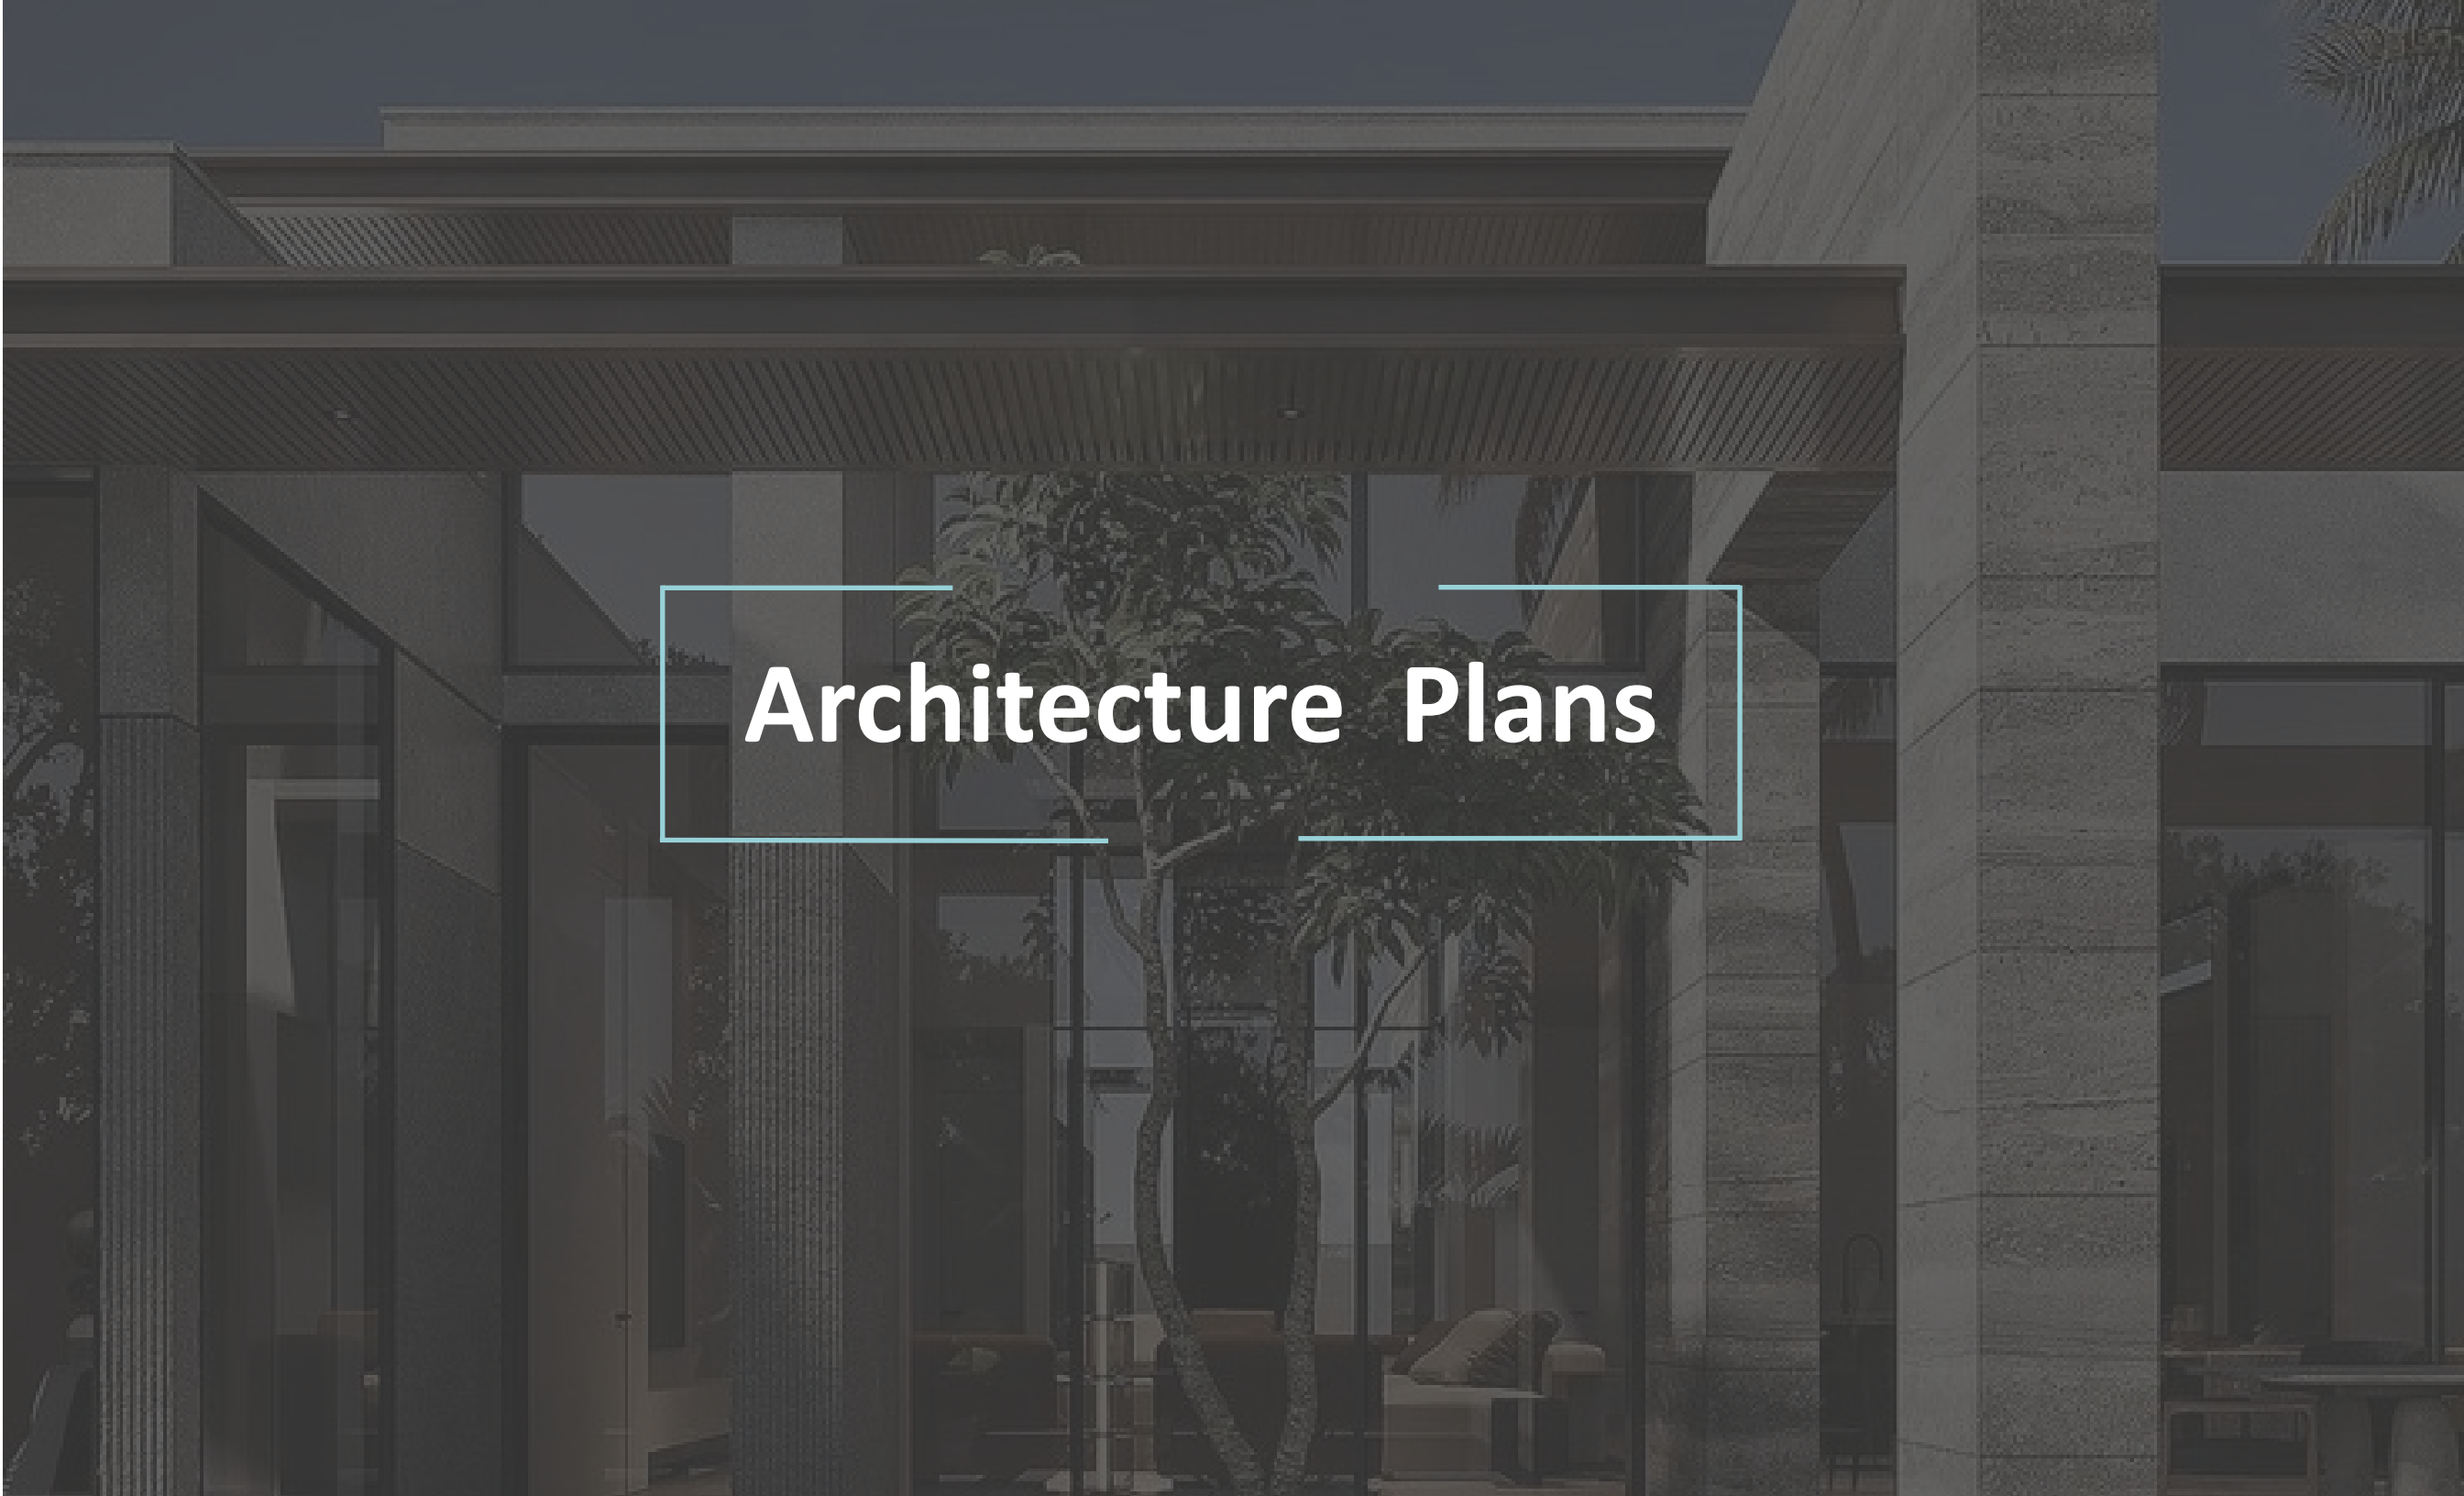


A dark, atmospheric photograph of a modern building's exterior. The building features large glass windows and a prominent central tree. The scene is dimly lit, with the building's structure and the tree's silhouette being the primary visual elements. A light blue rectangular frame is superimposed over the center of the image, containing the text "Architecture Plans".


Architecture Plans

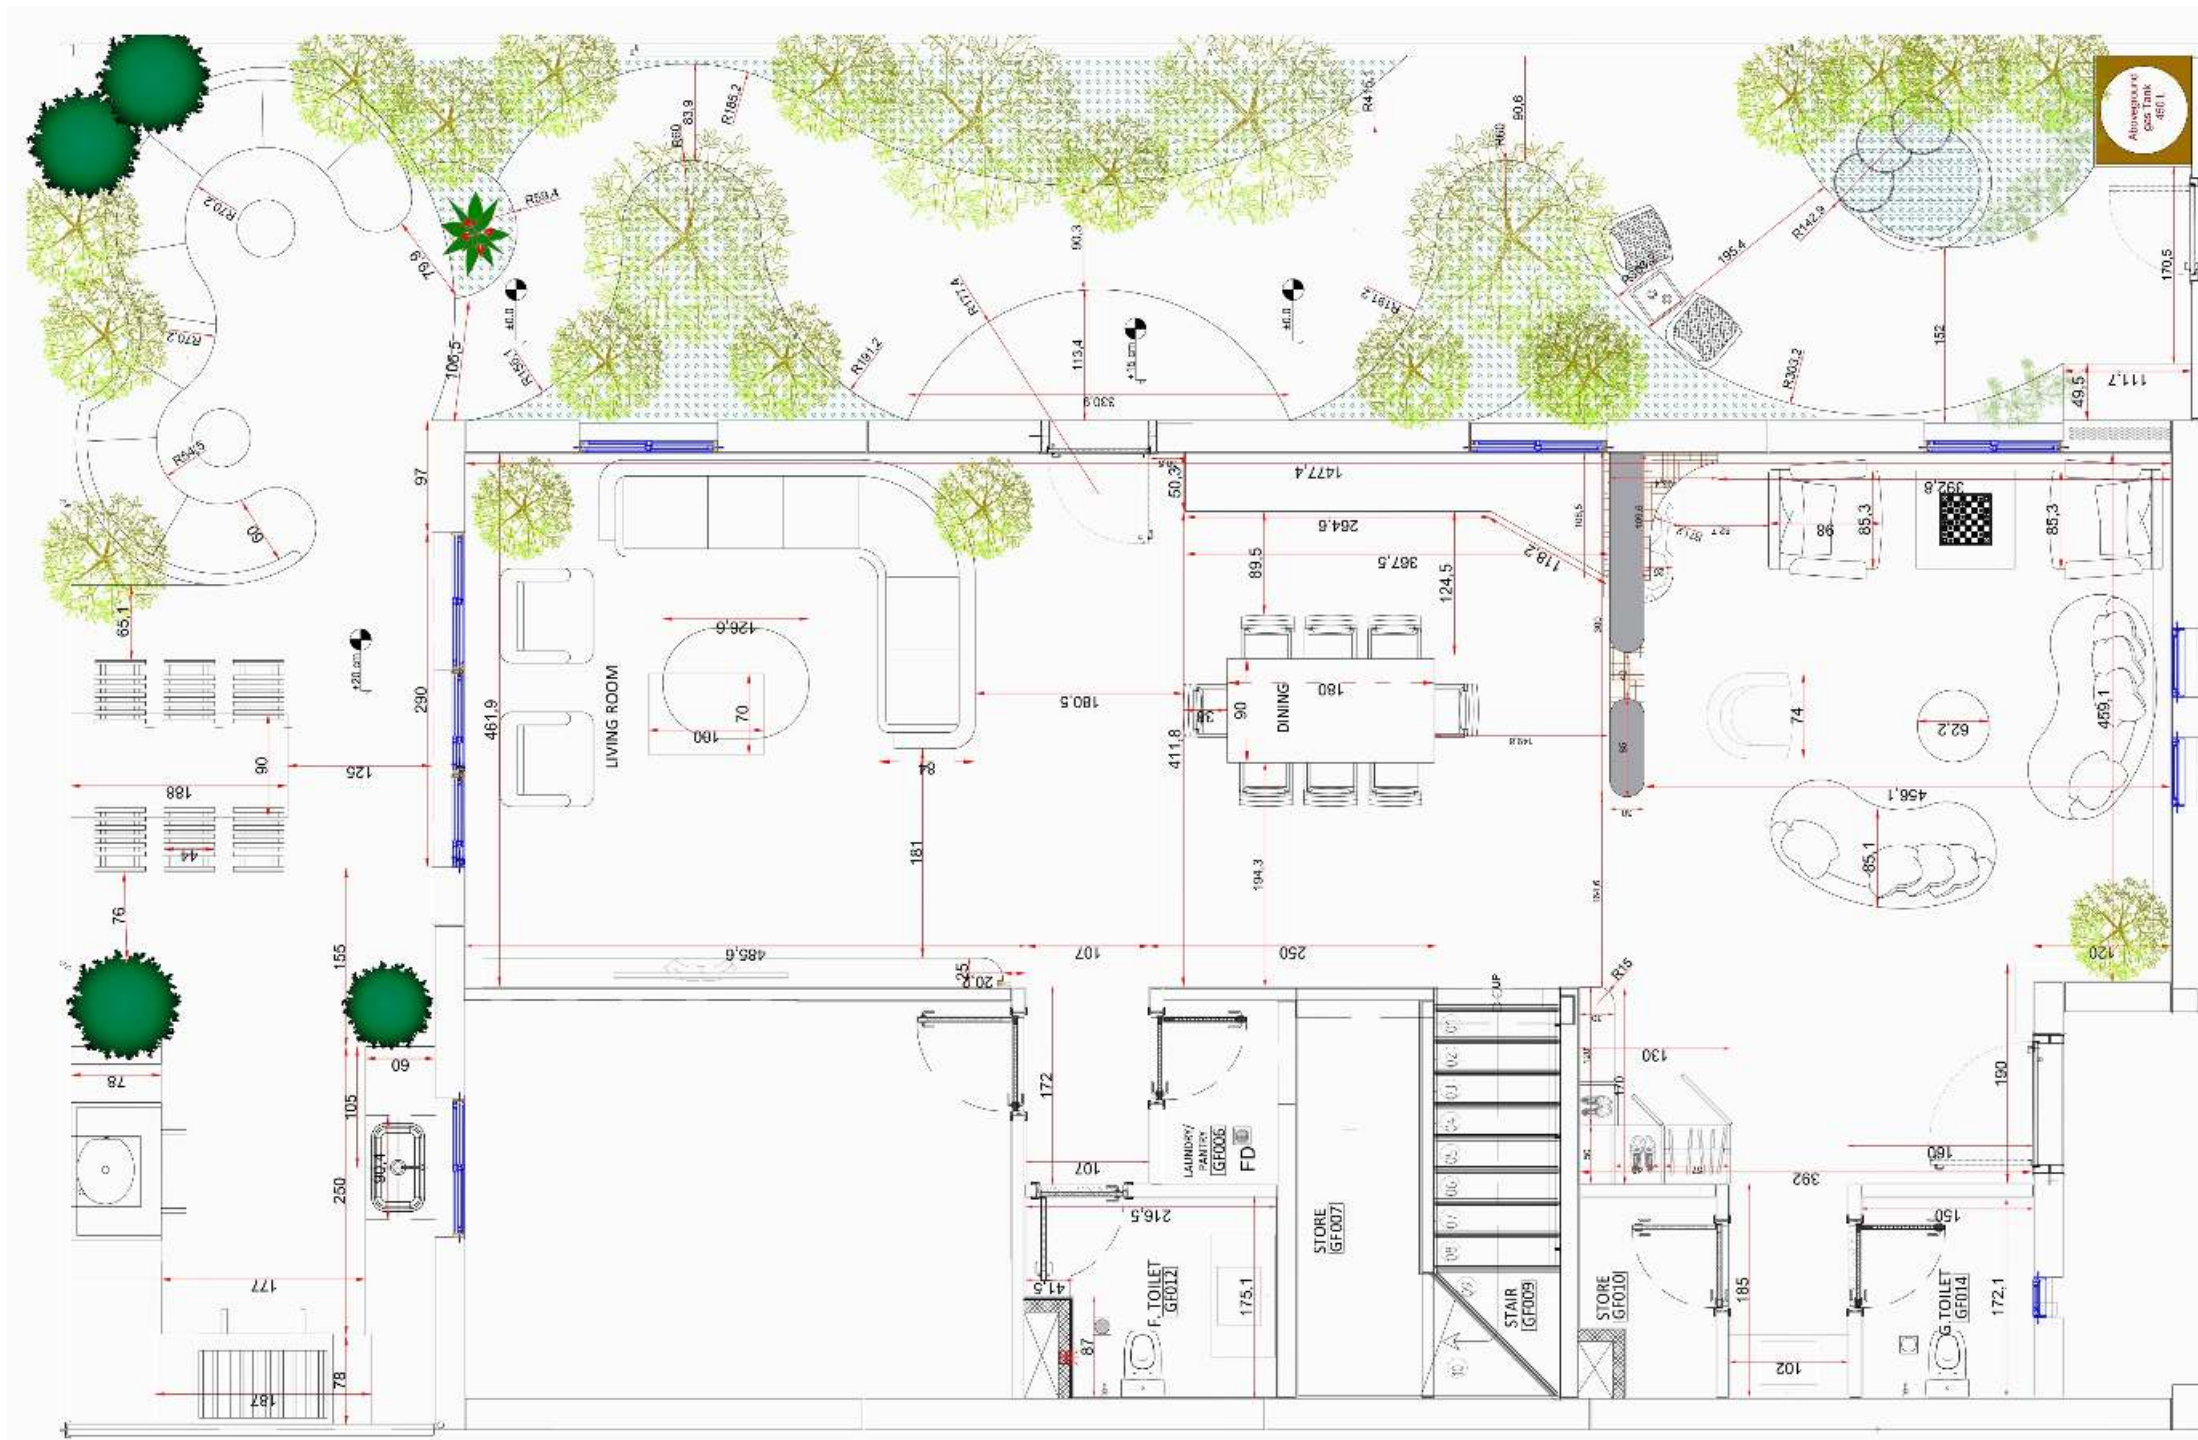


Ground
Floor

First Floor



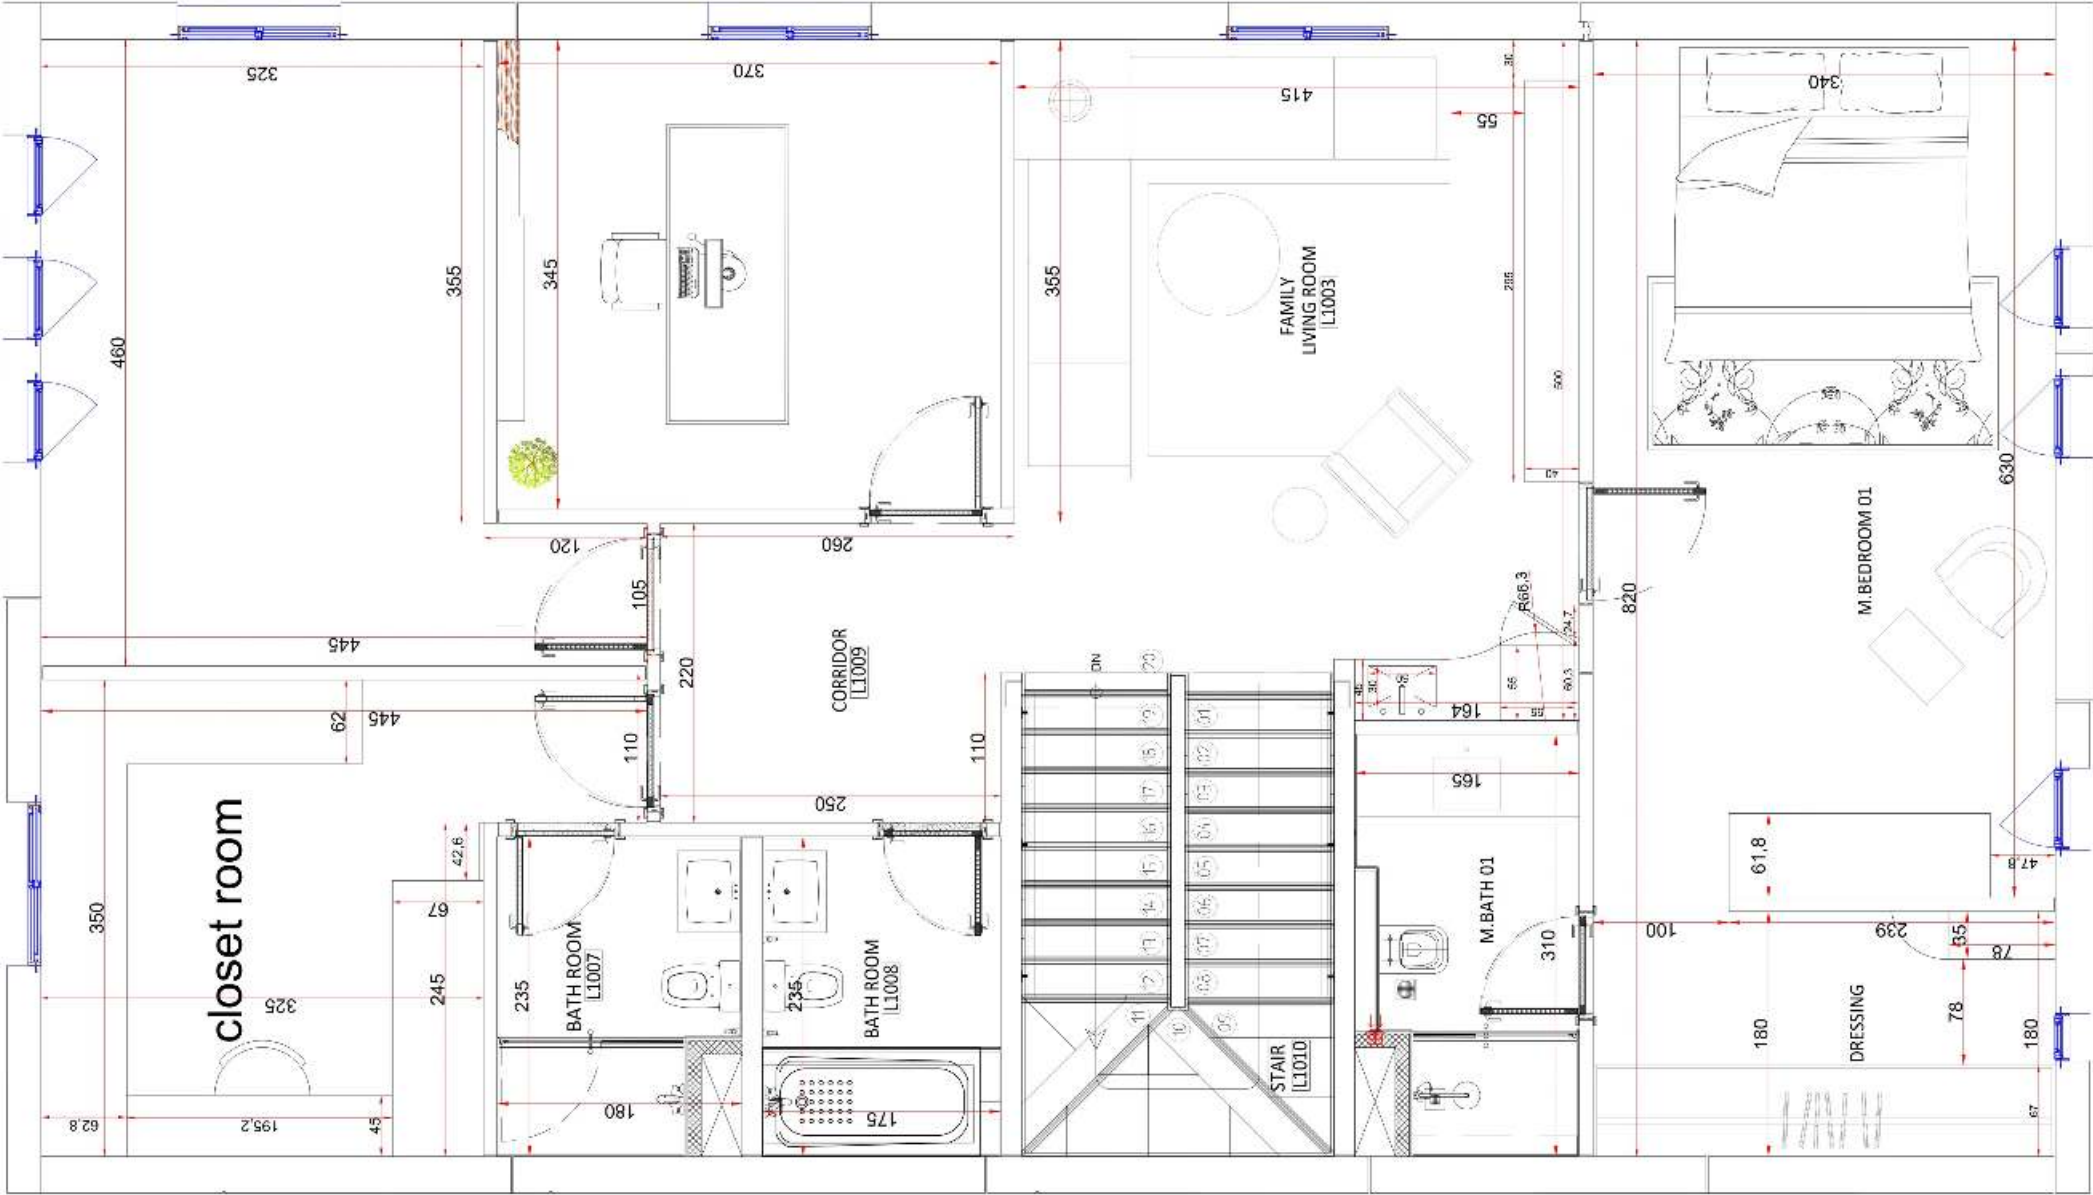


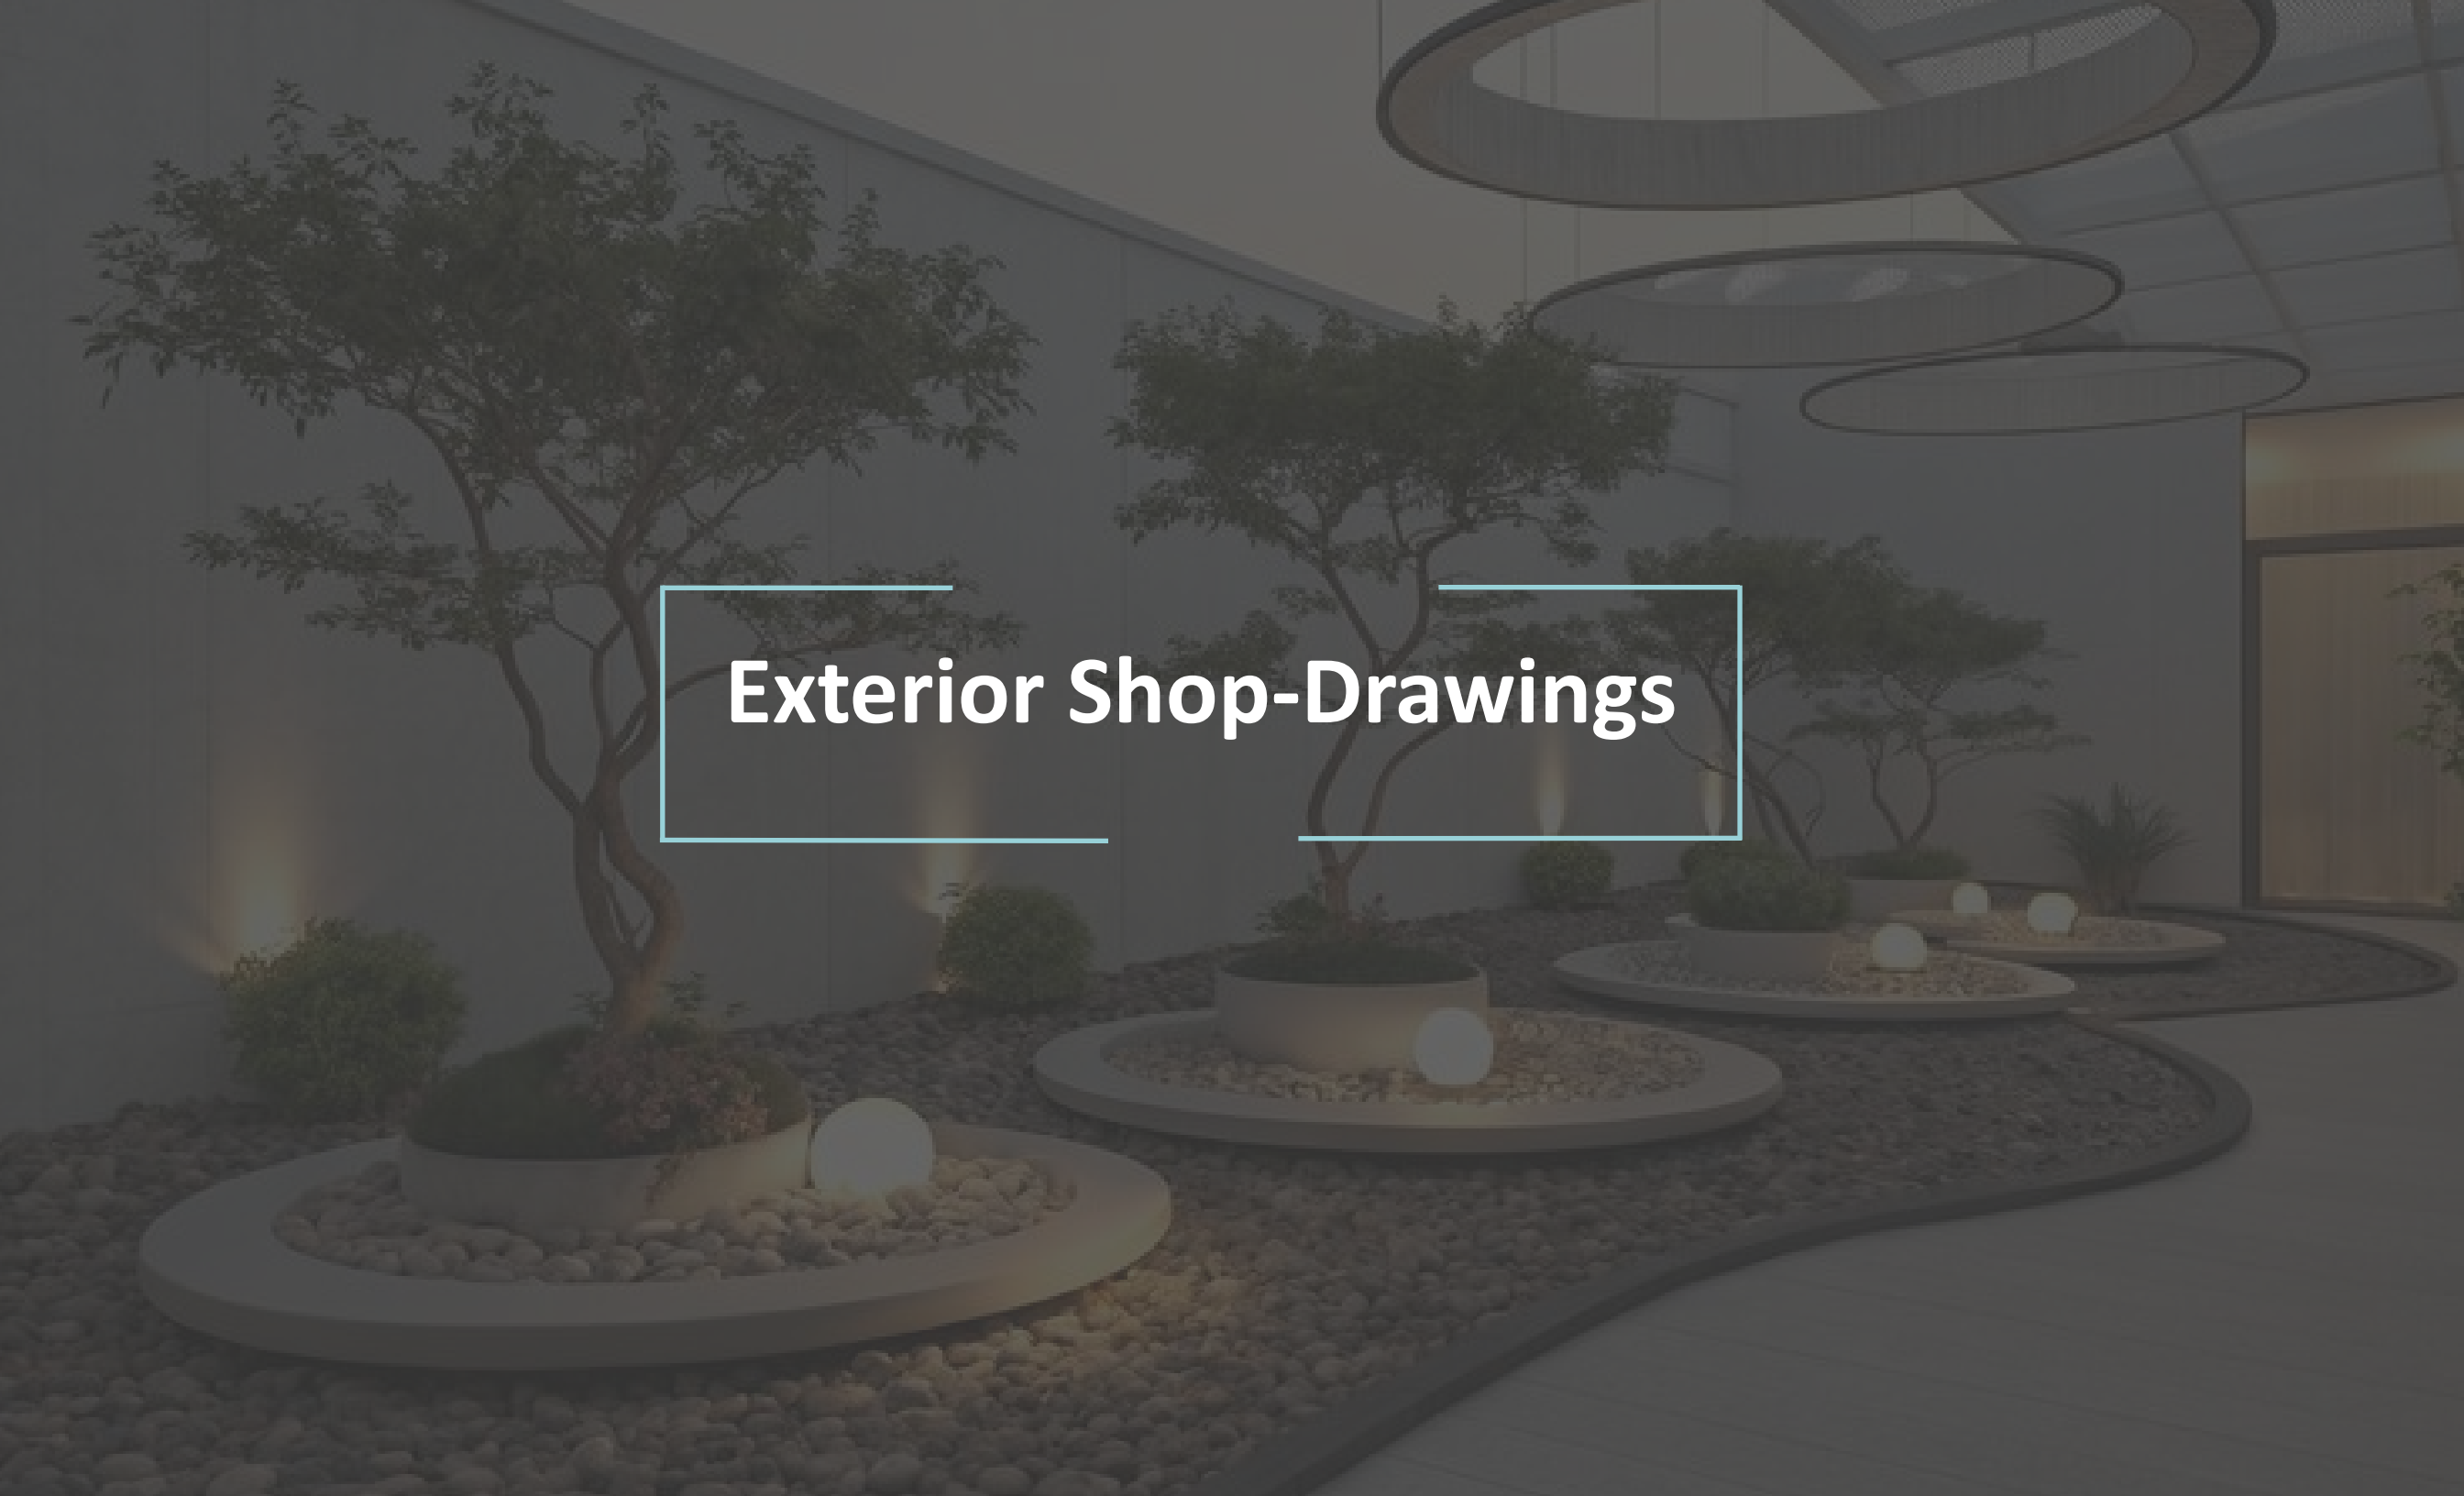A modern courtyard landscape design featuring a series of circular, raised planters arranged in a curved path. Each planter contains a small tree or shrub and is surrounded by light-colored gravel. The planters are set against a backdrop of a modern building with large glass windows and a curved, metallic structure. The overall aesthetic is clean and minimalist.

Exterior Shop-Drawings

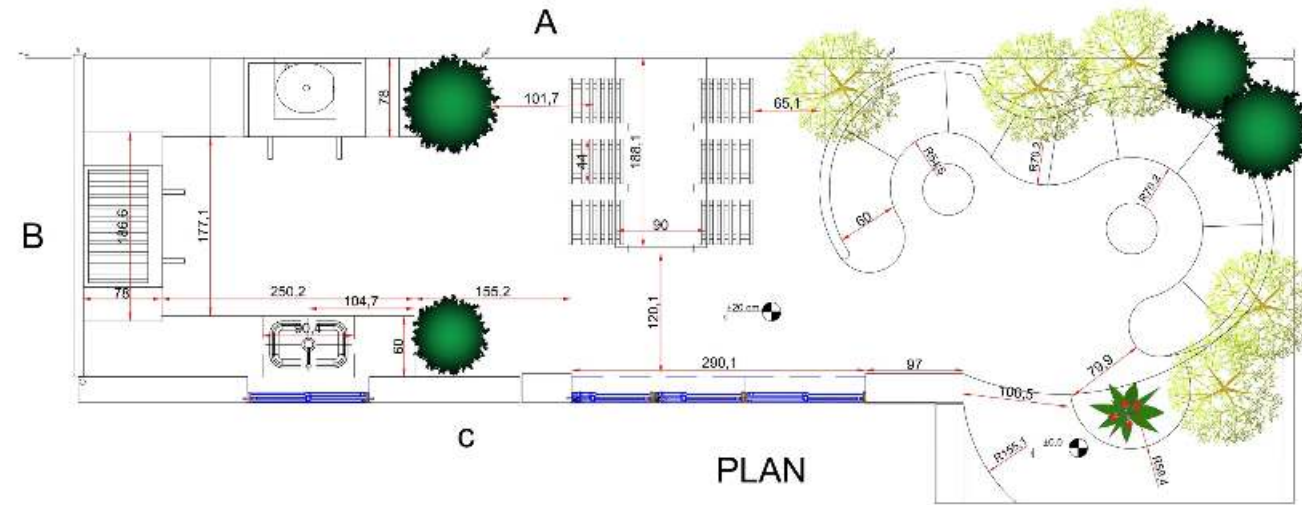


Elevation

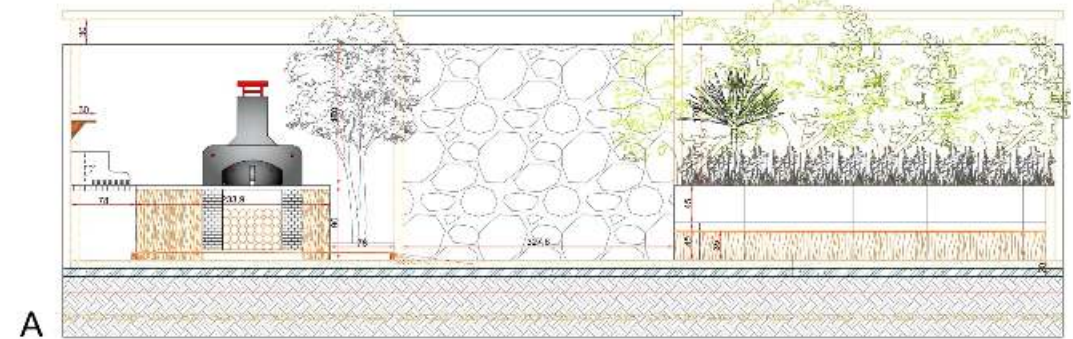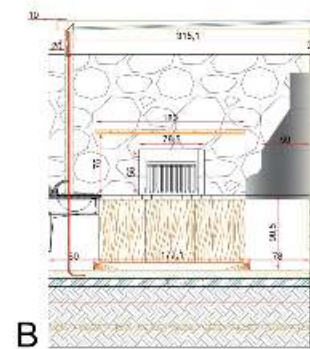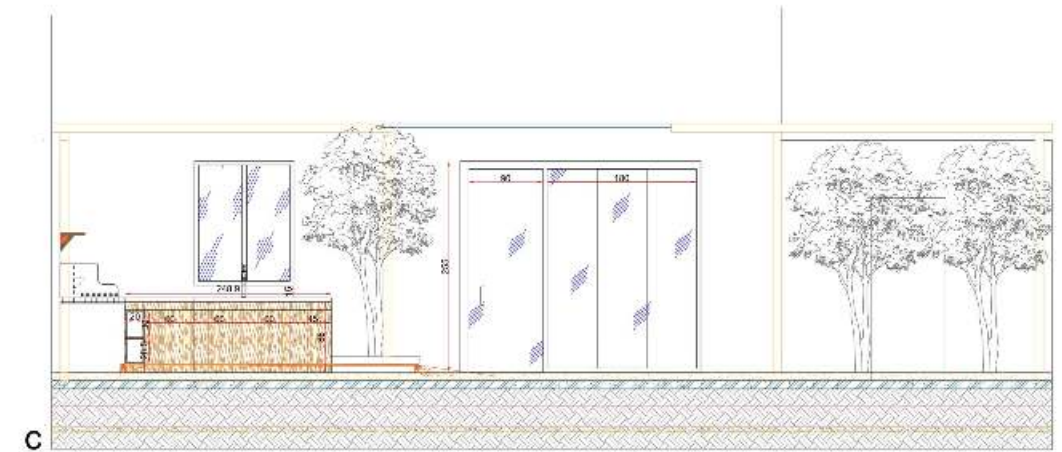





Interior Shop-Drawings

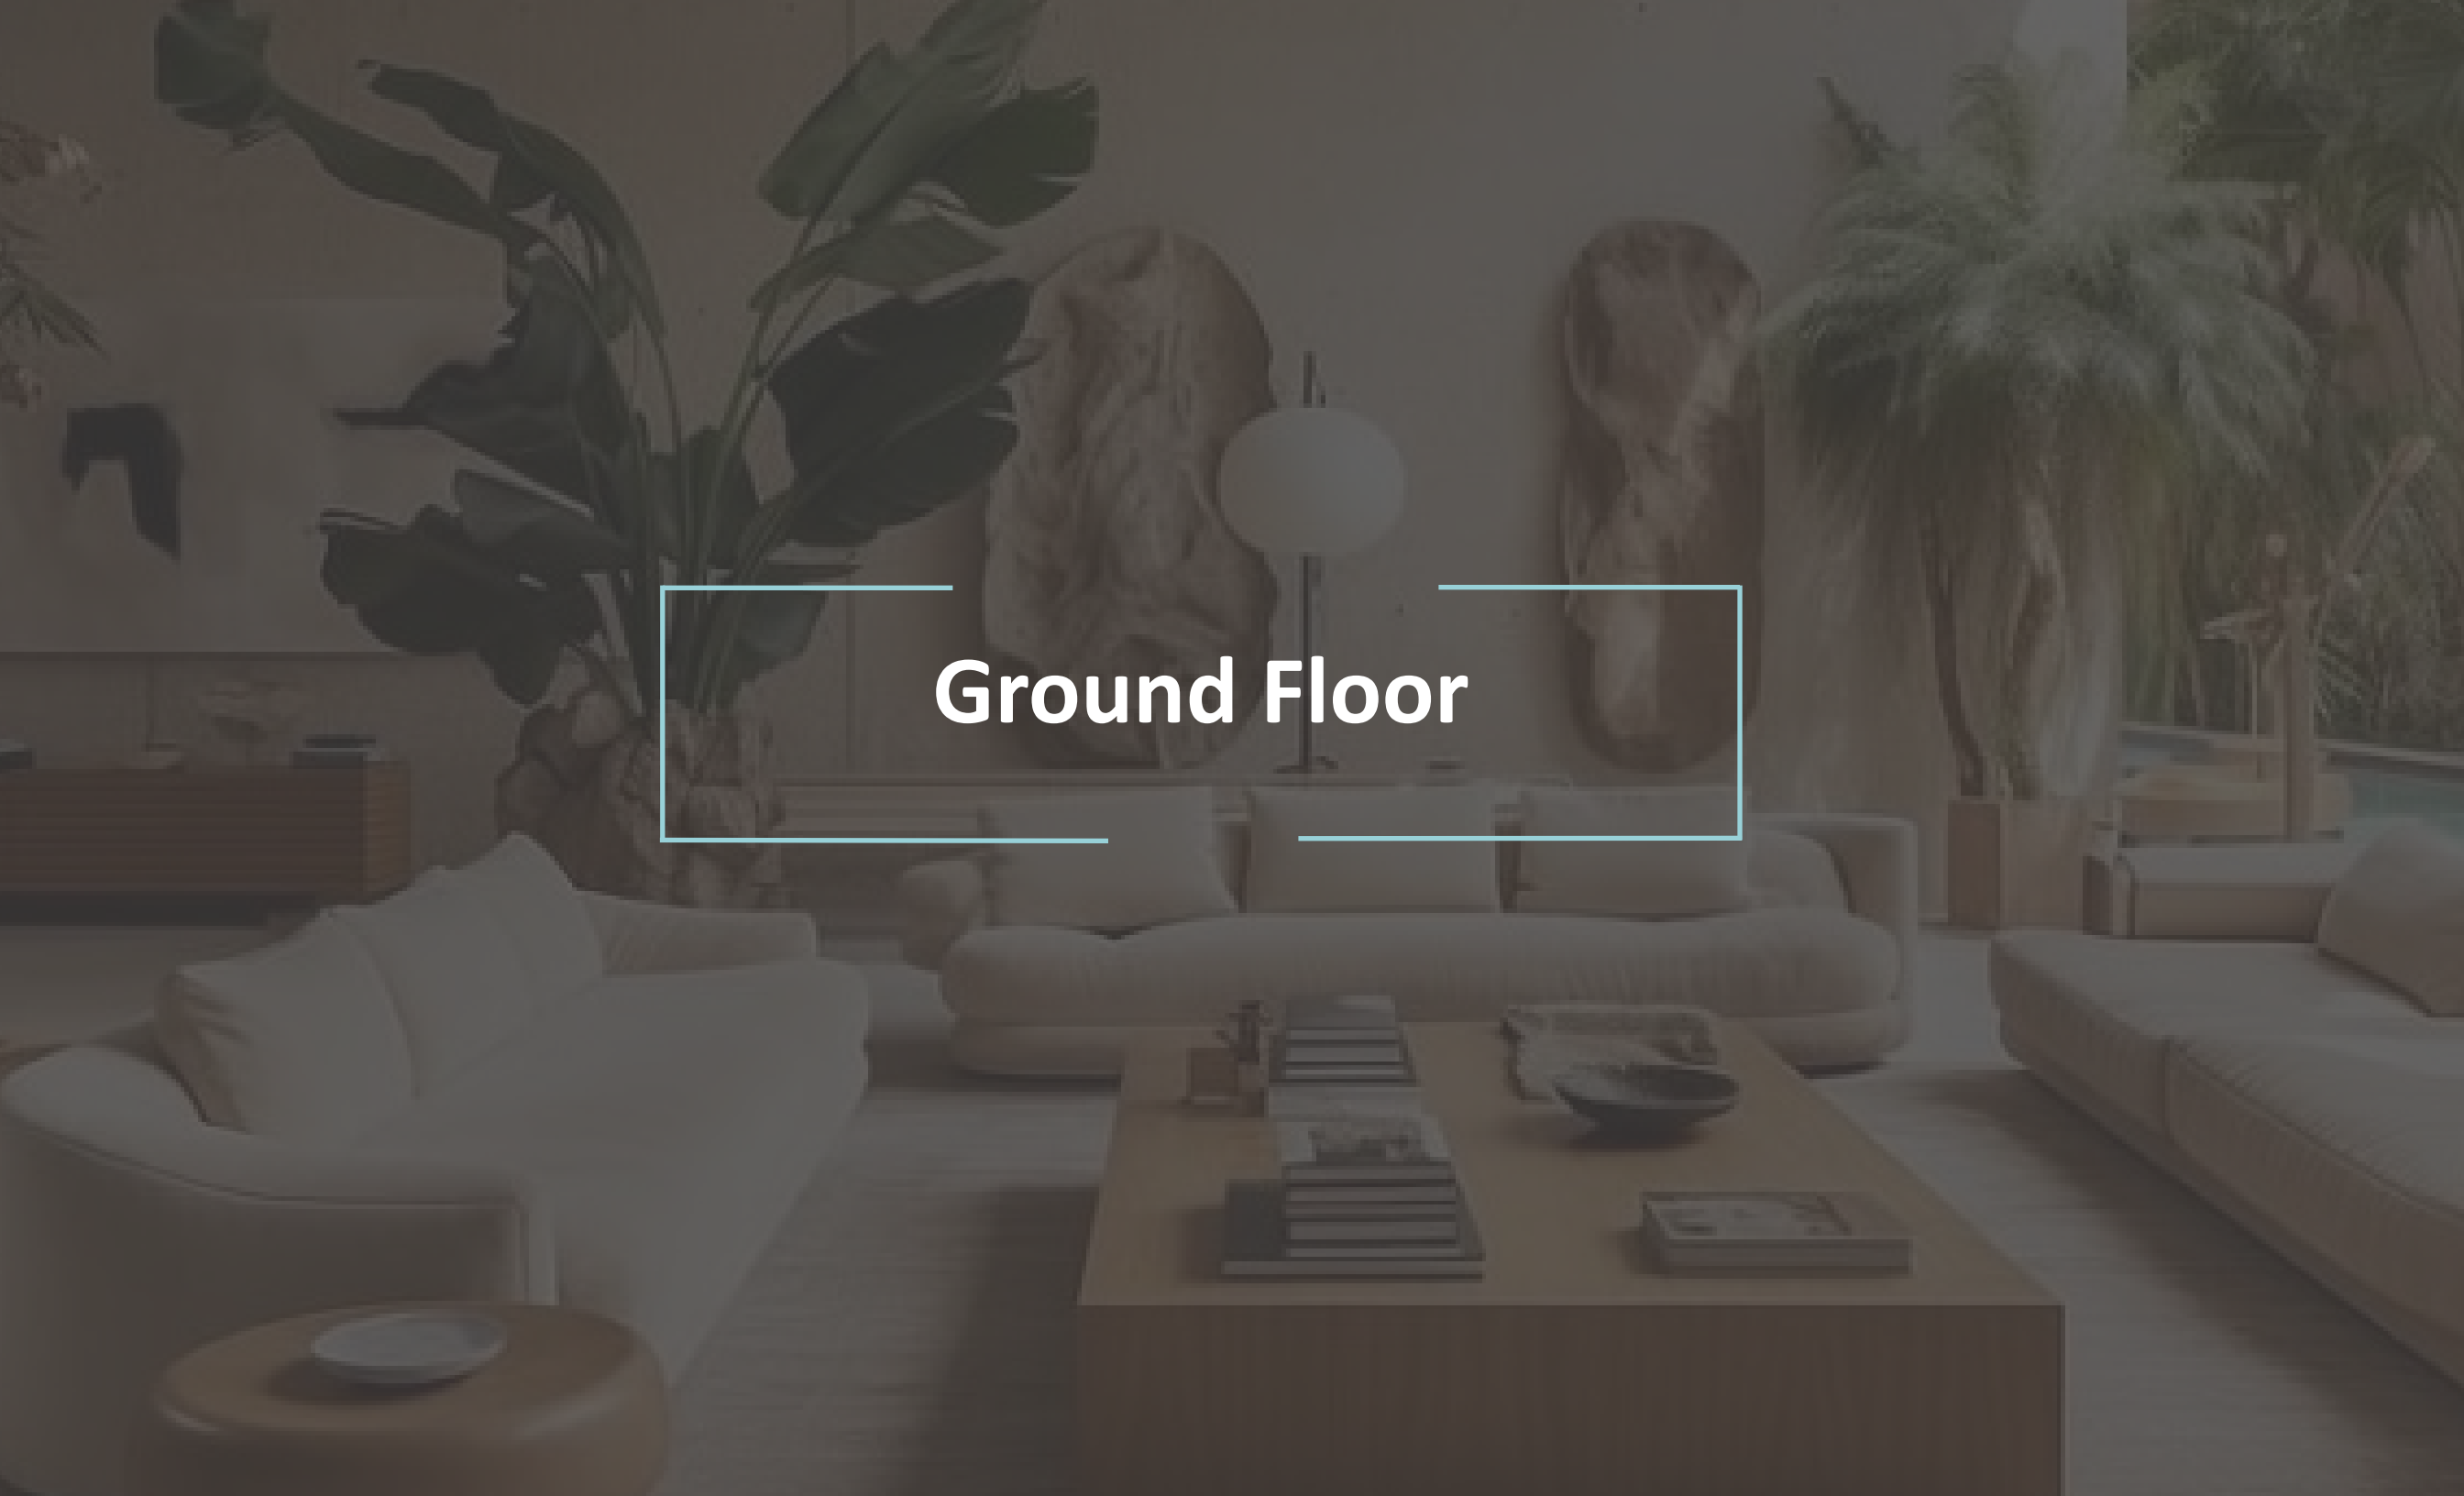

Ground Floor

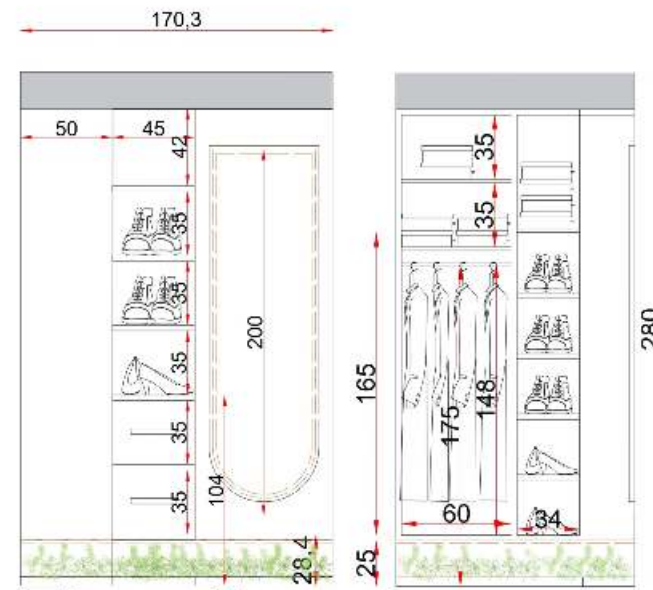


Elevation

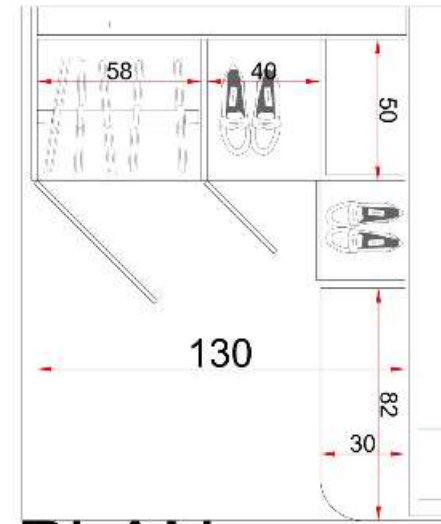


PLAN

Abaya closet



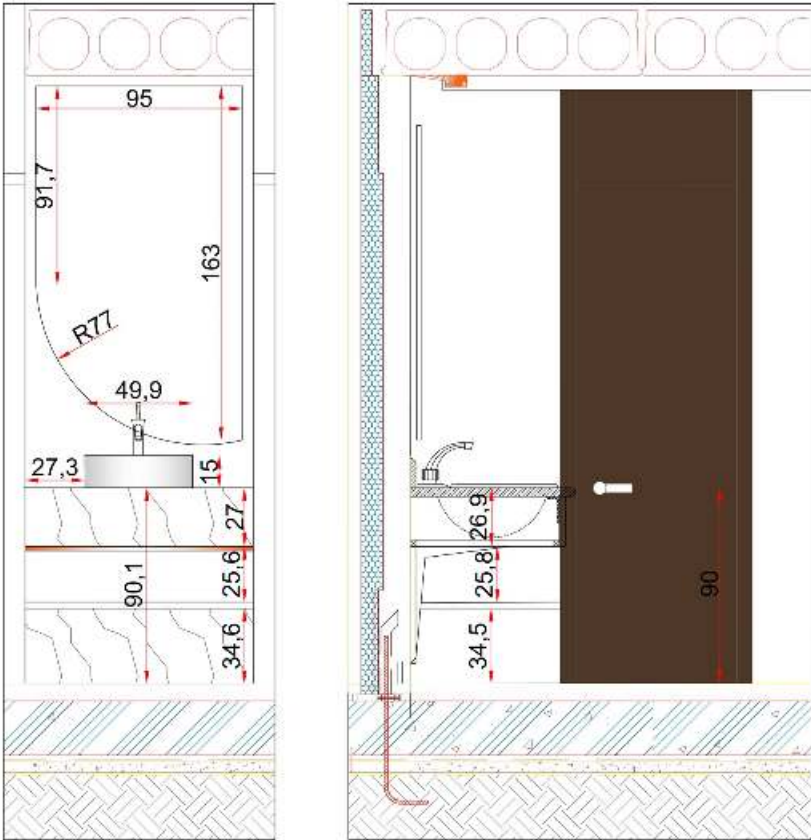



Elevation

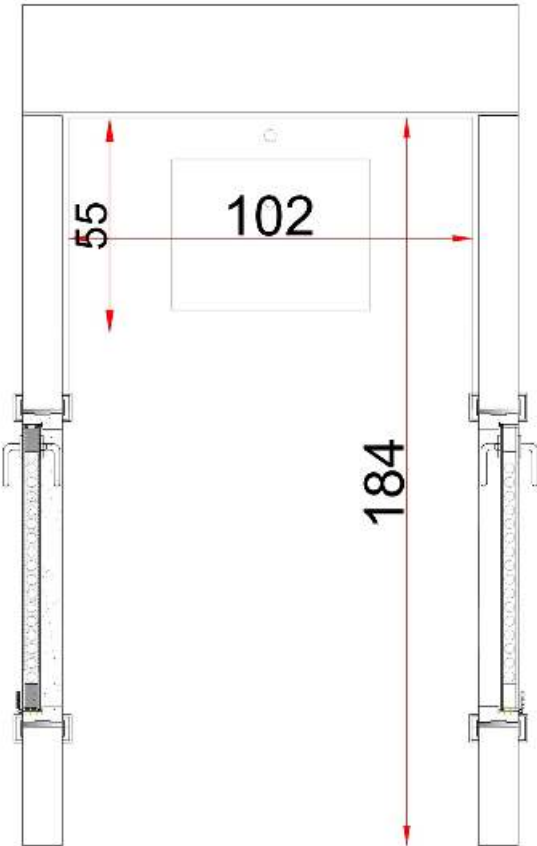


PLAN




Guest Bathroom

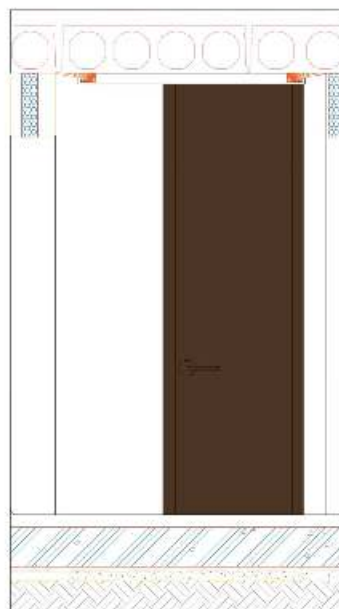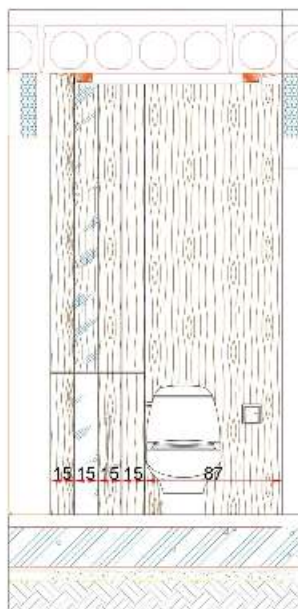


Elevation

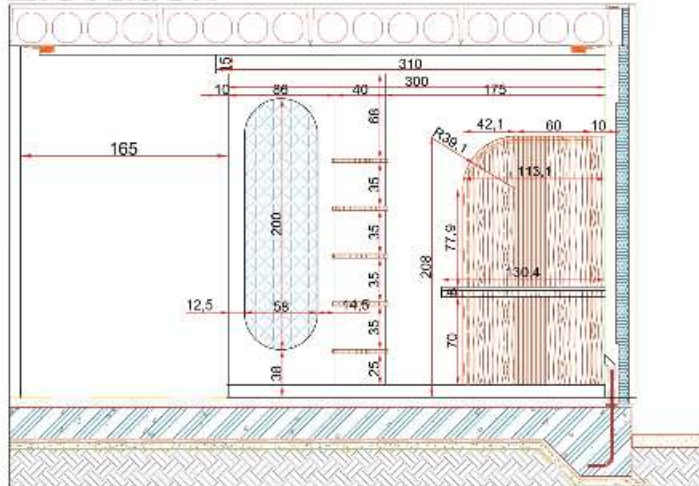


Elevation

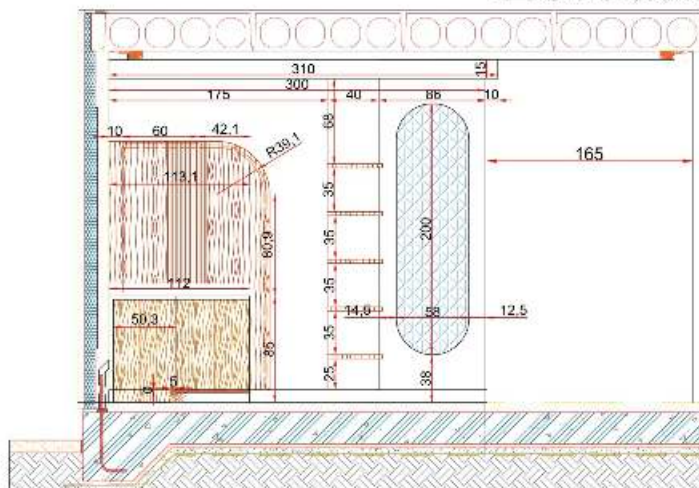


PLAN

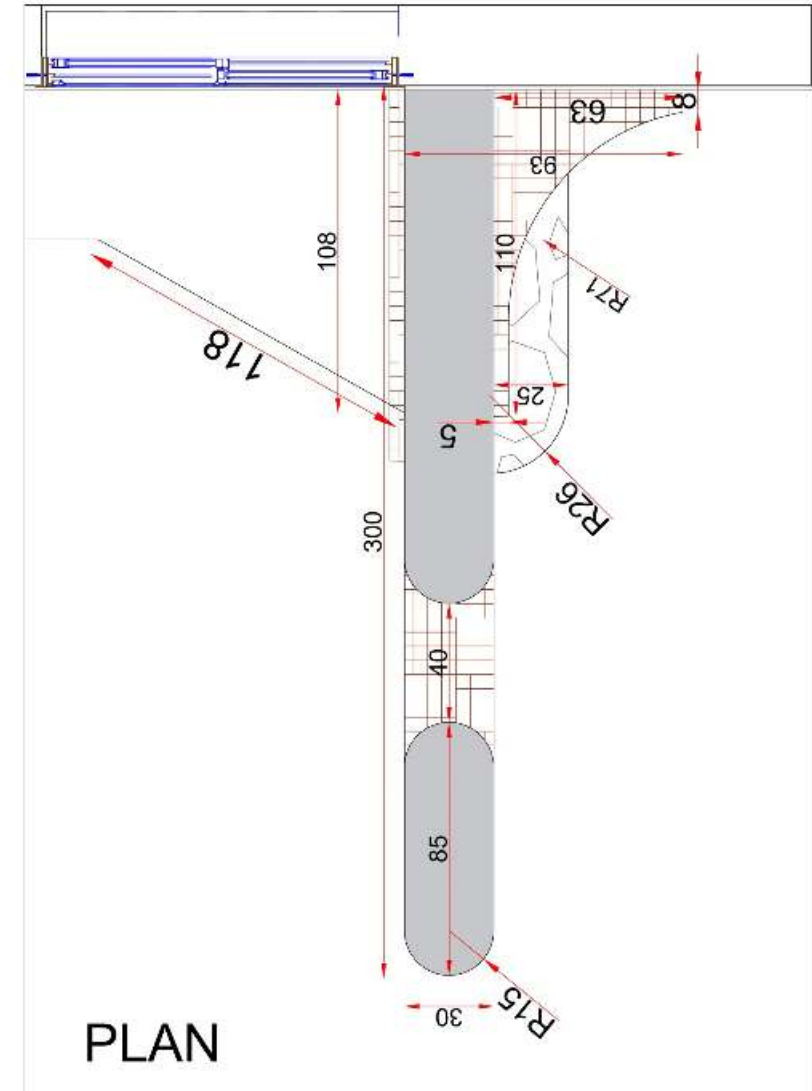


Elevation

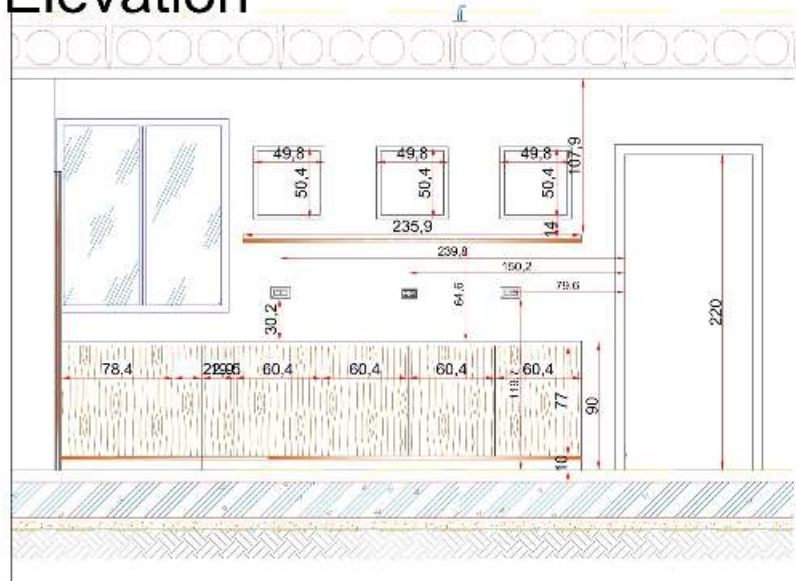


Elevation

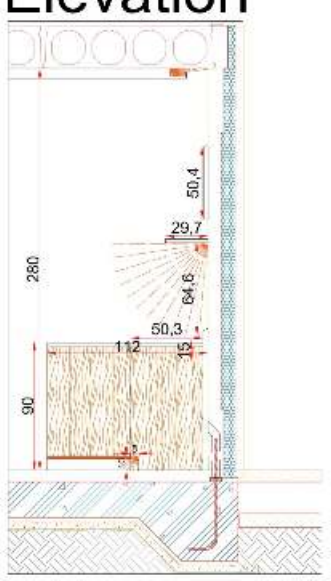

Serving Table

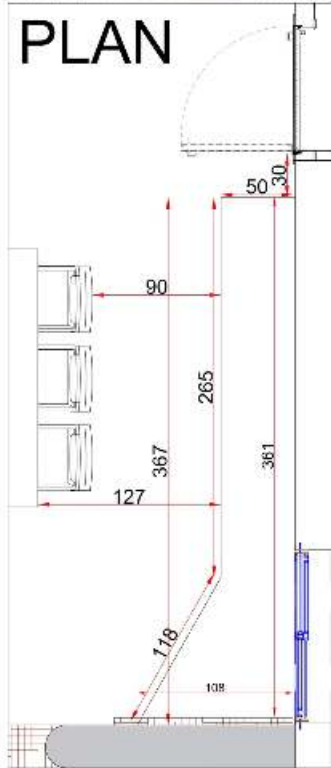


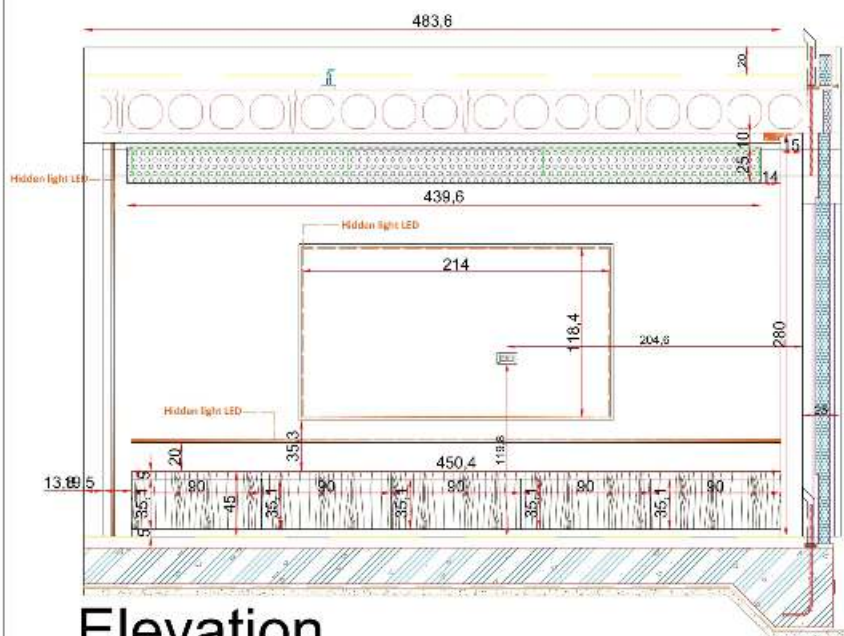


Elevation



PLAN

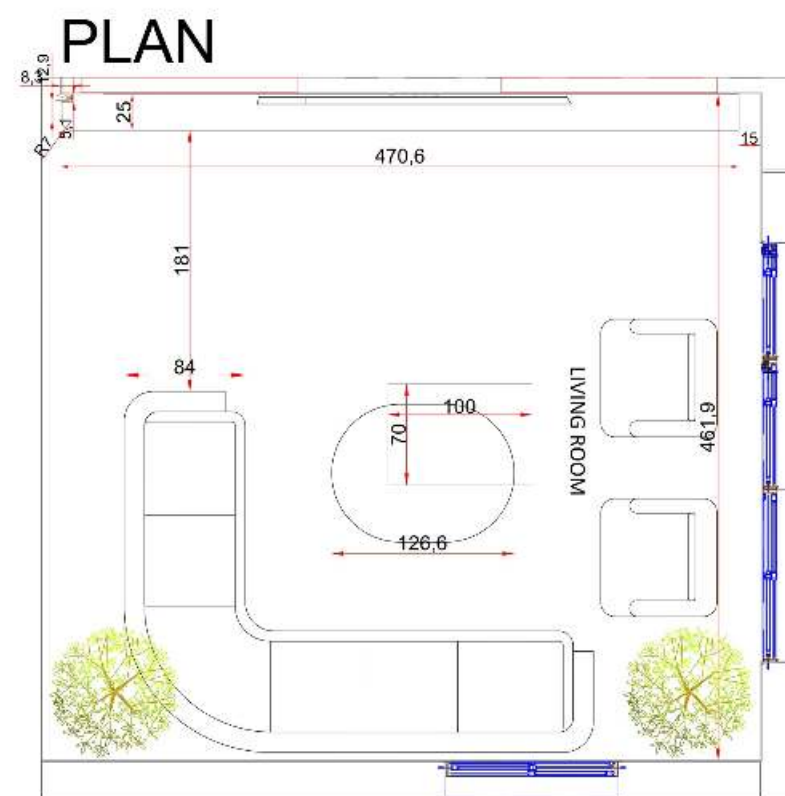

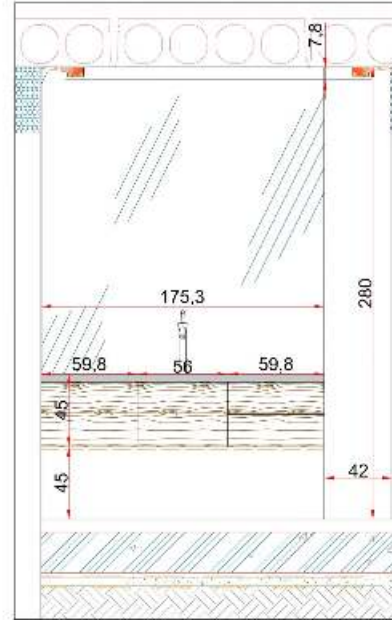


Elevation




PLAN



Family Bathroom

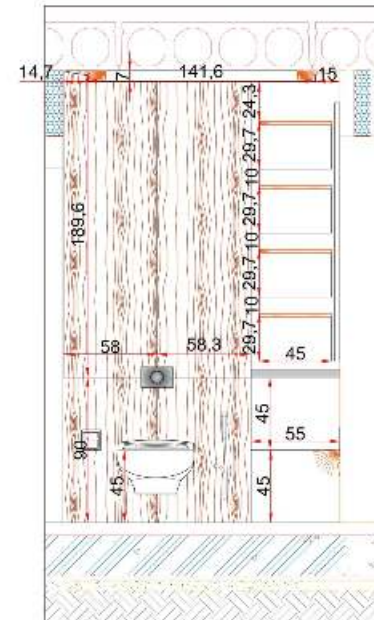

Elevation


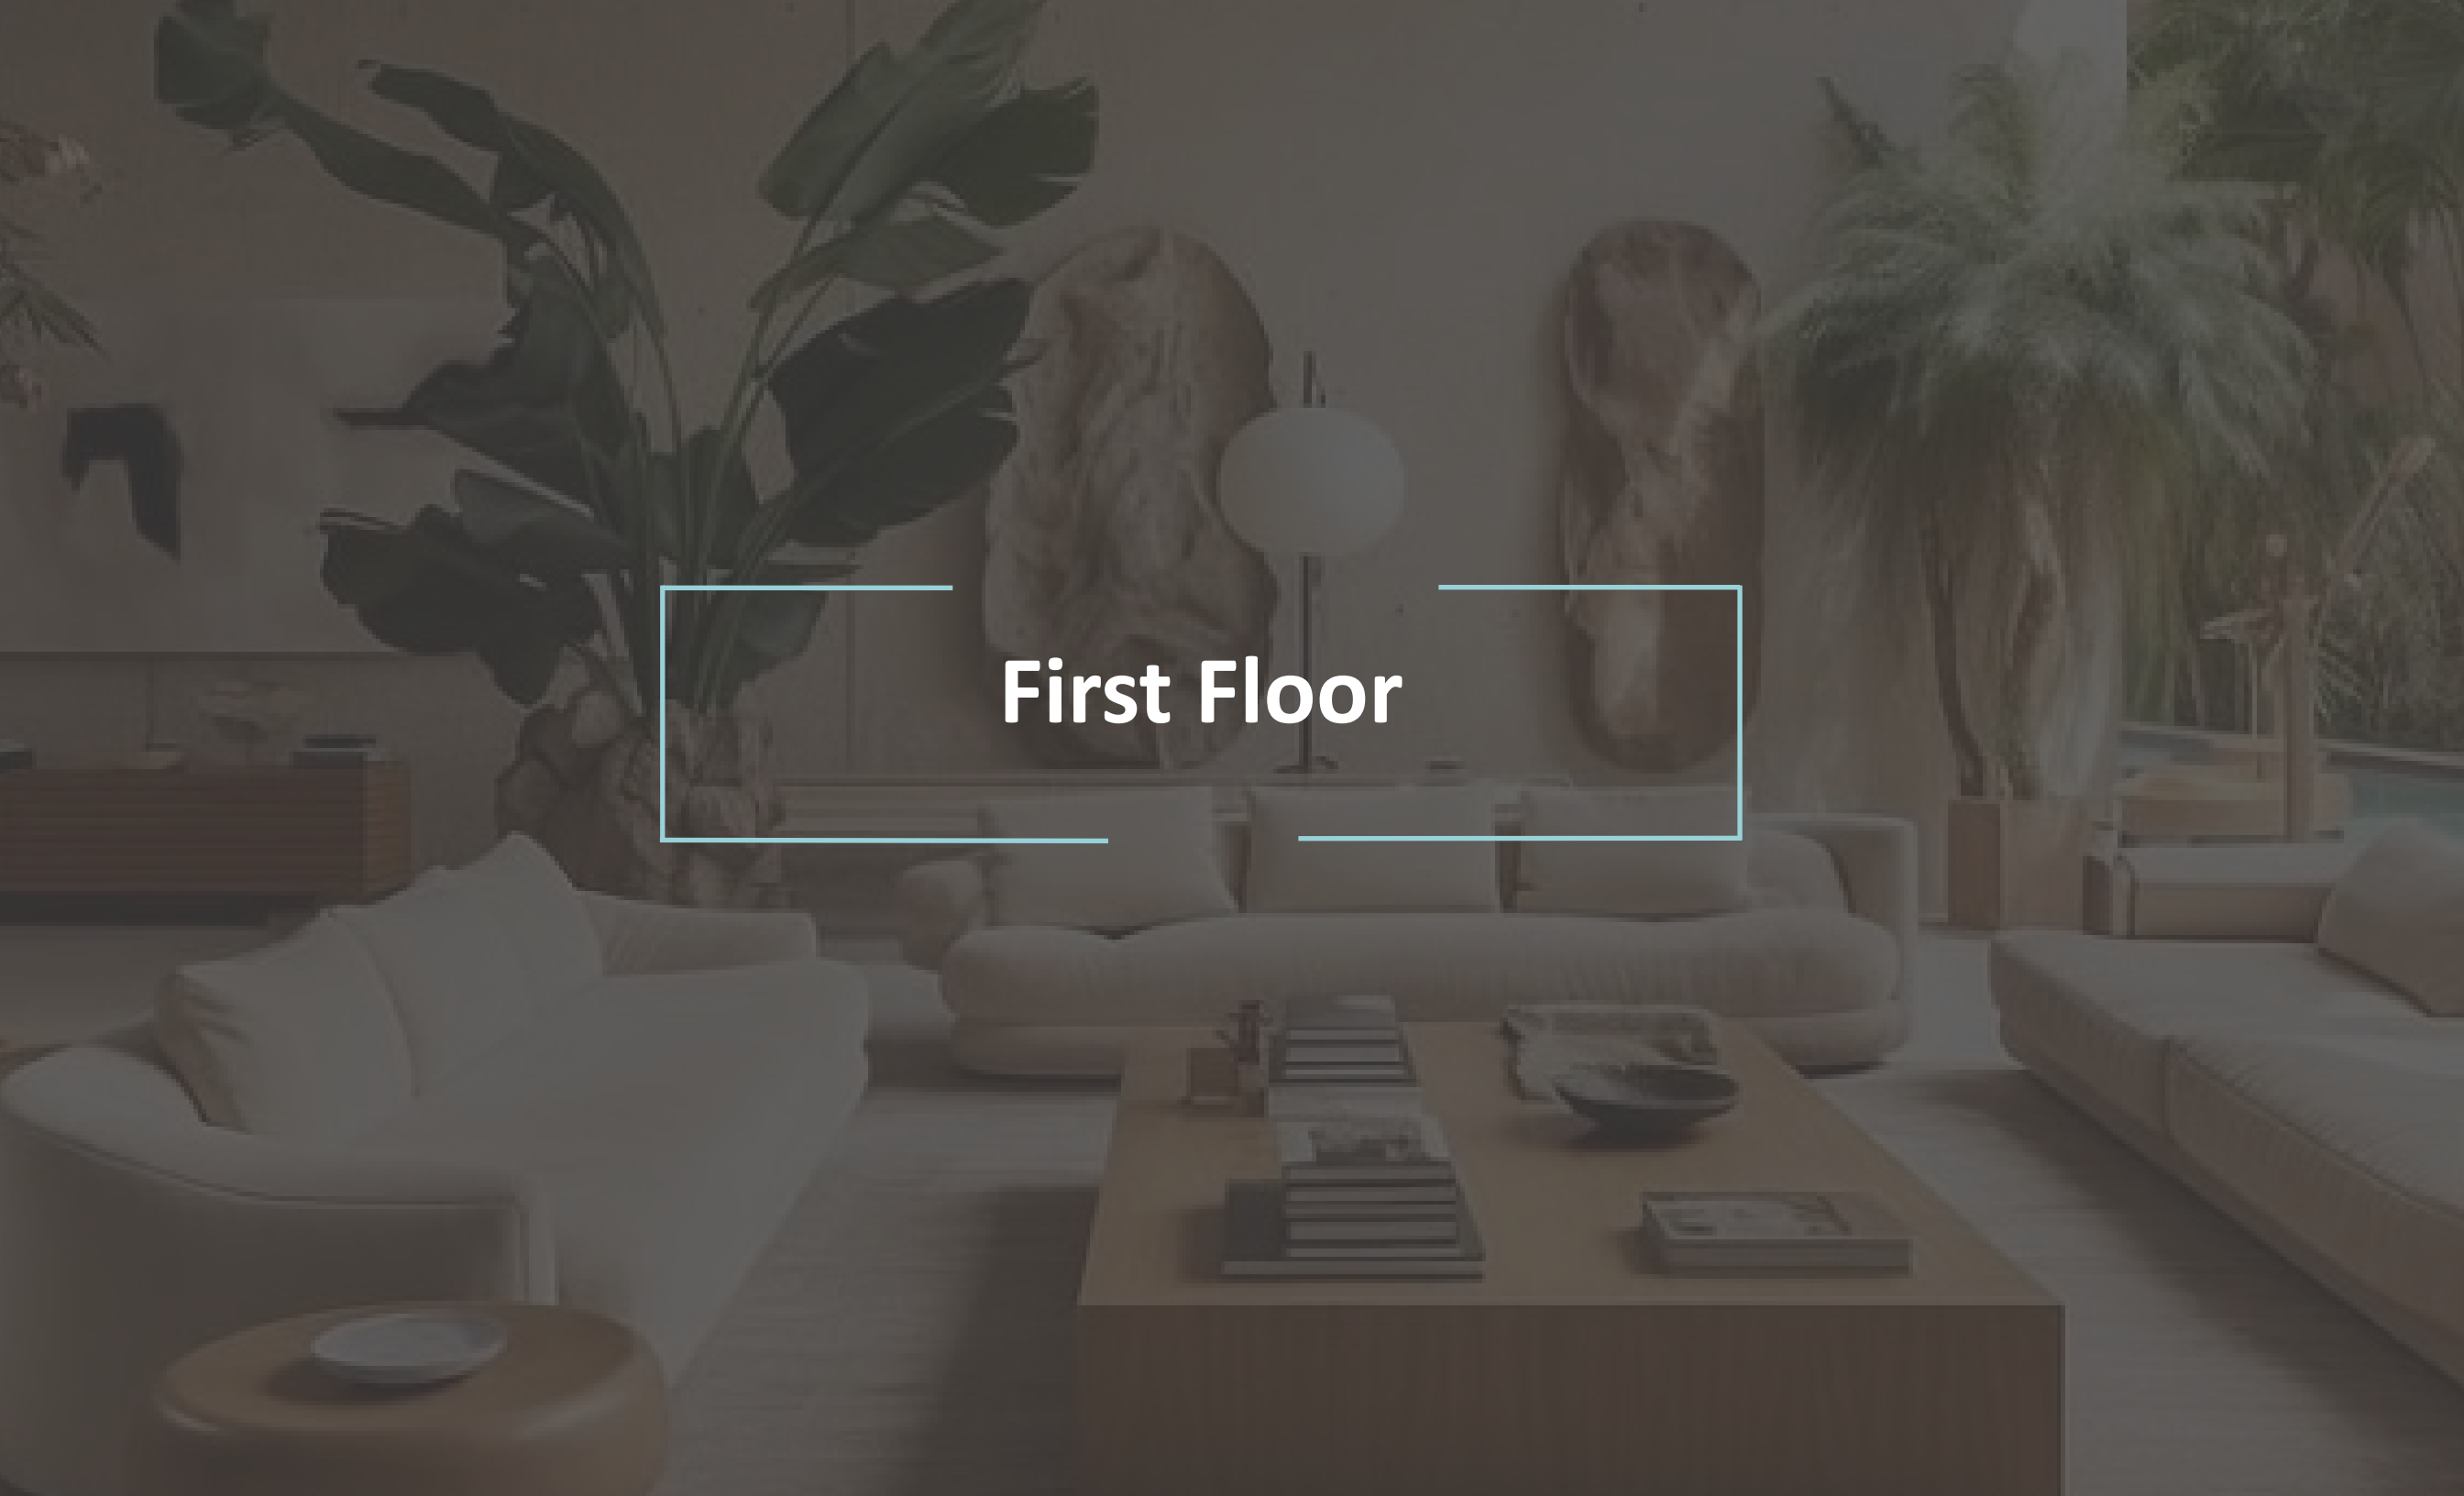


First Floor

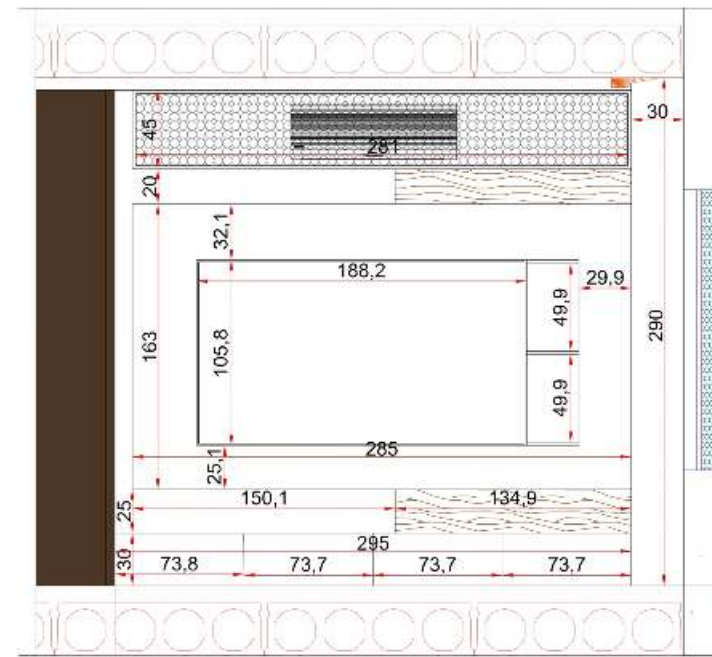
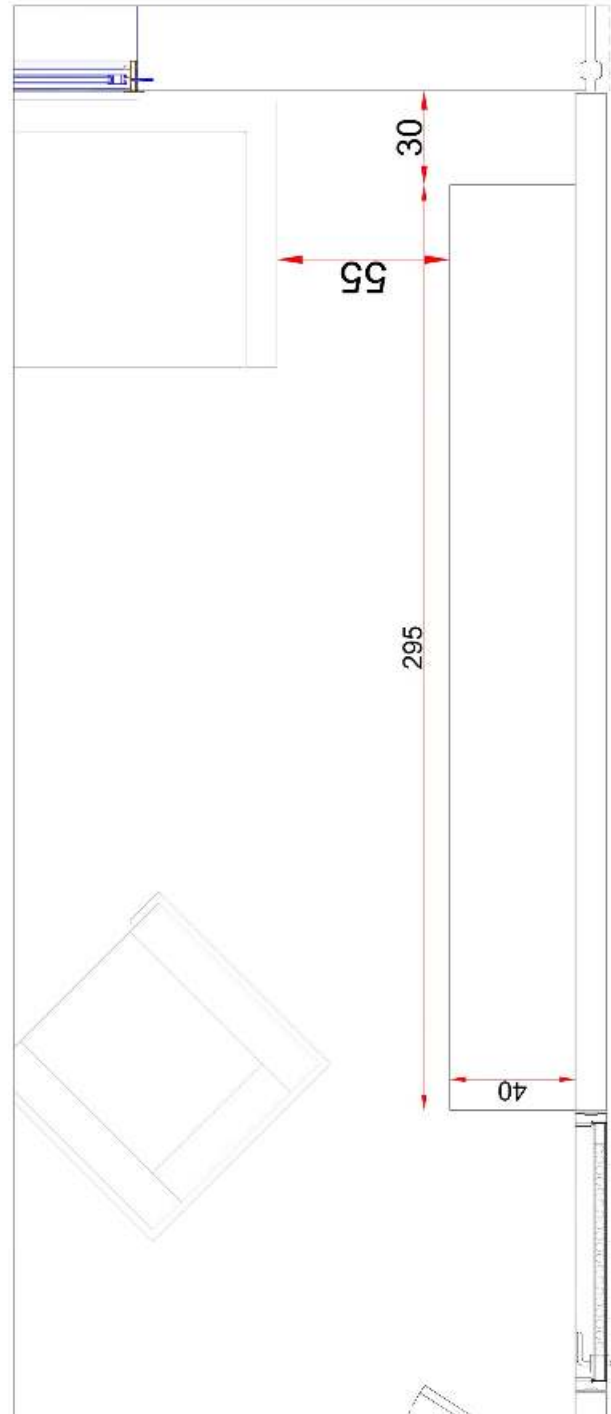


Tv Wall



Coffee corner

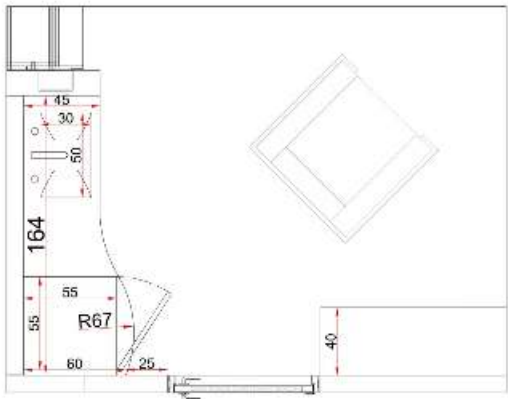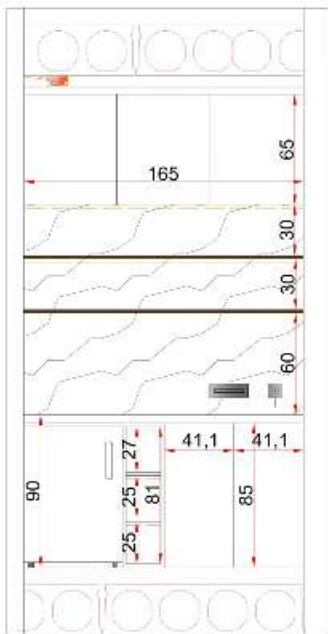

Office

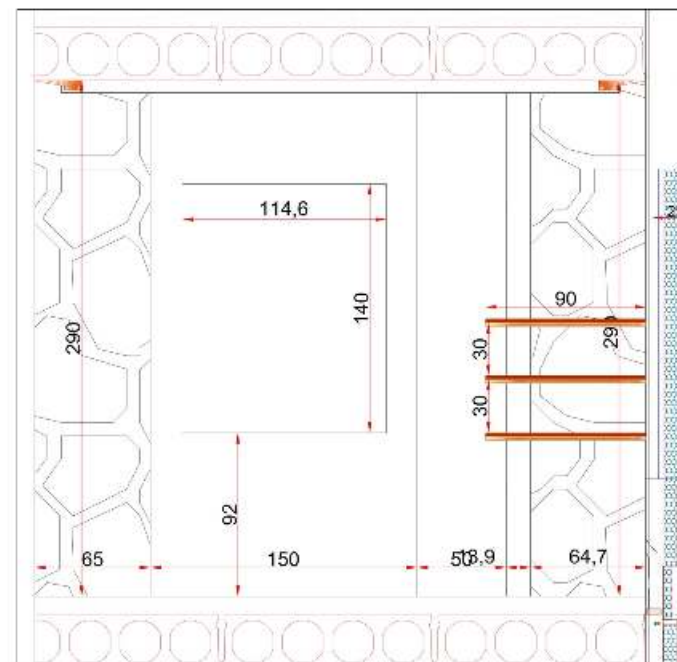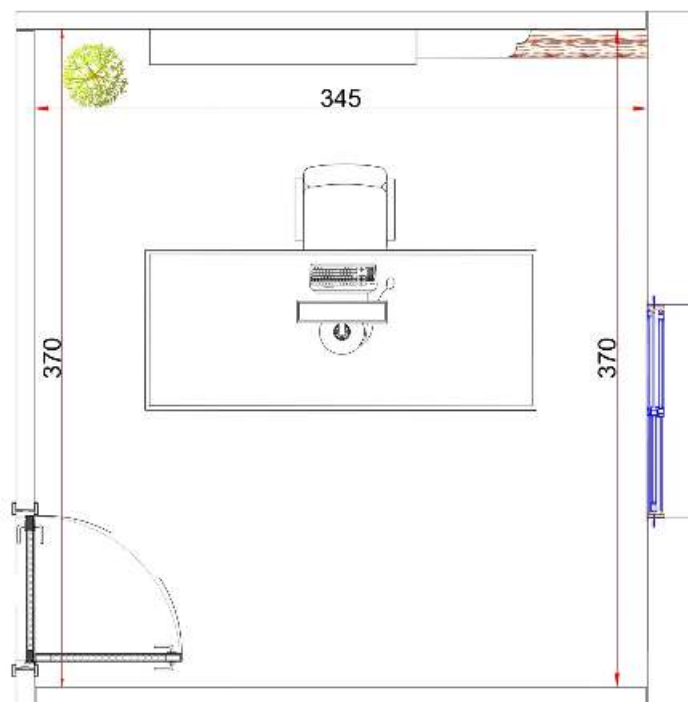


Family Bathroom

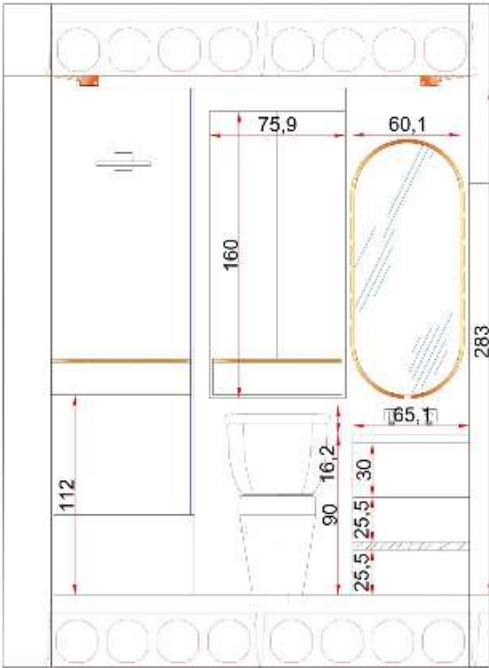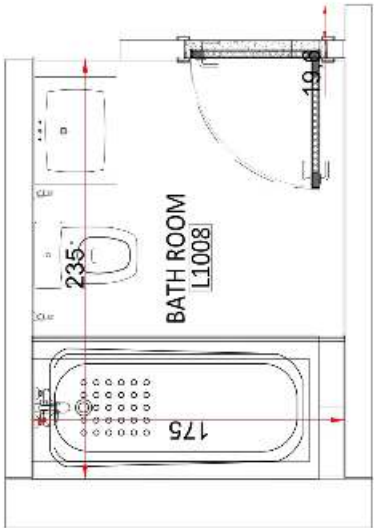


family BR




Dressing


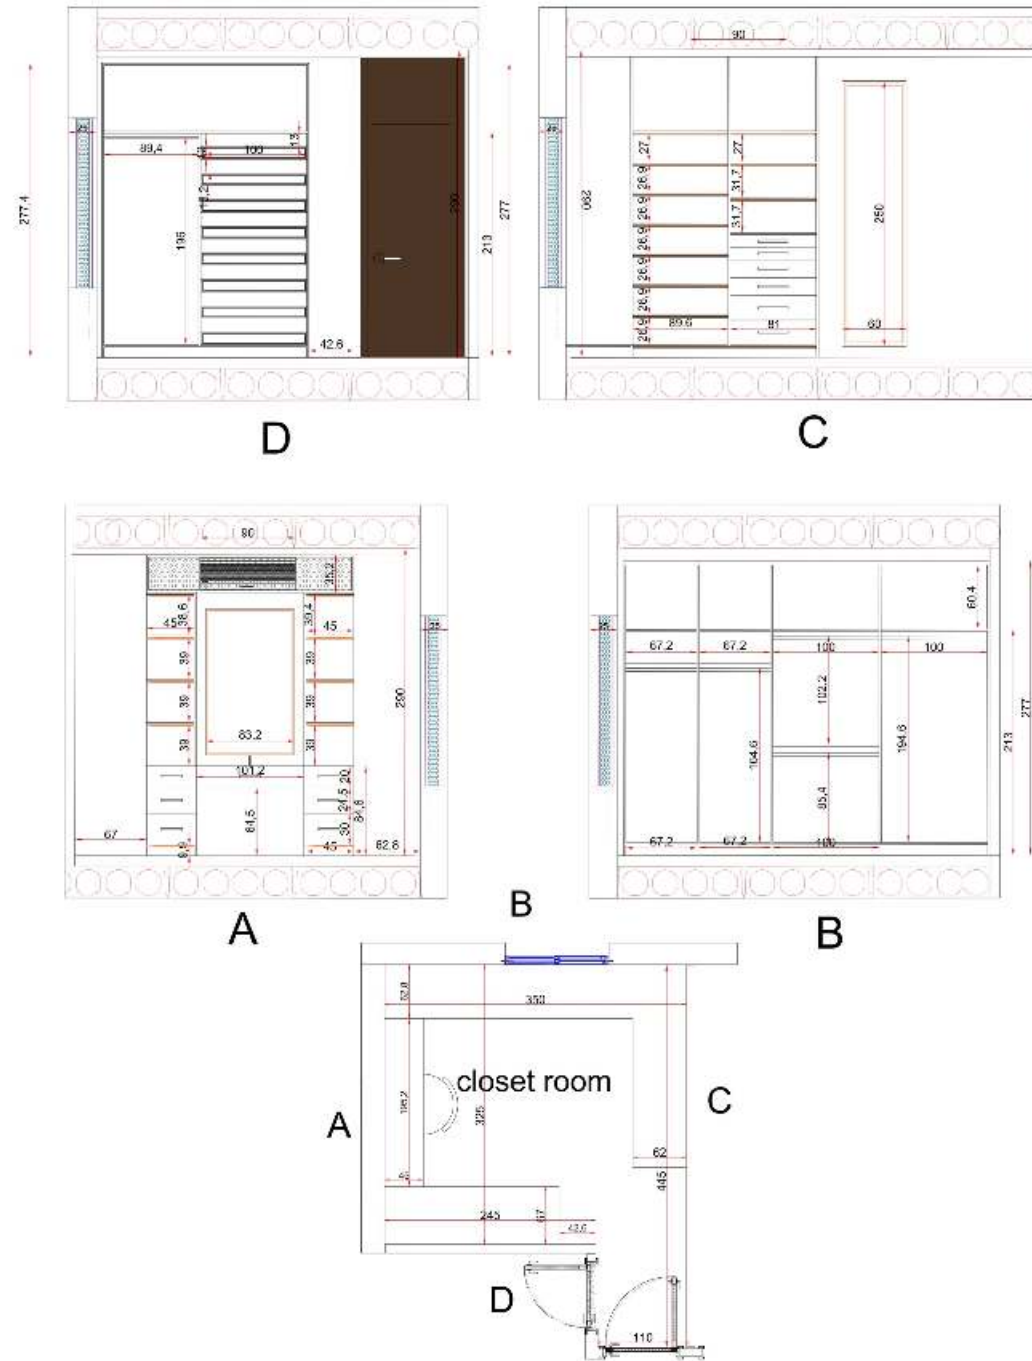


Dressing Bathroom

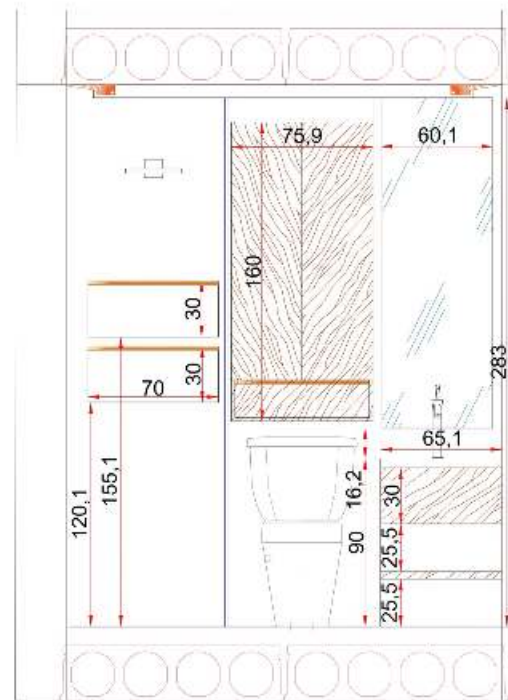



Dressing BR

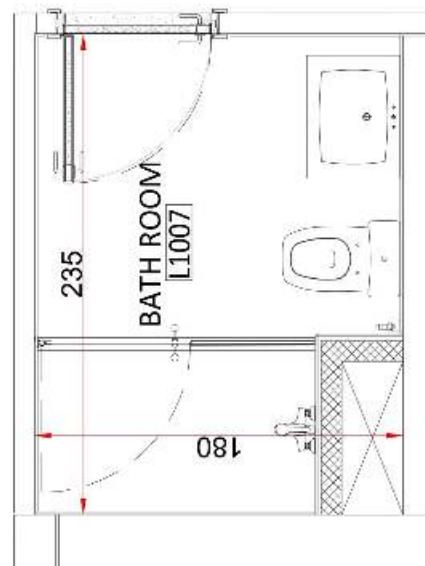

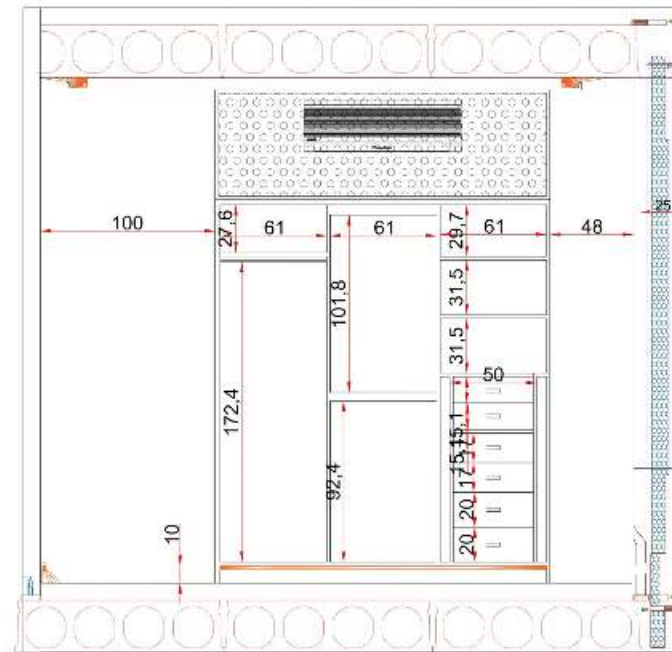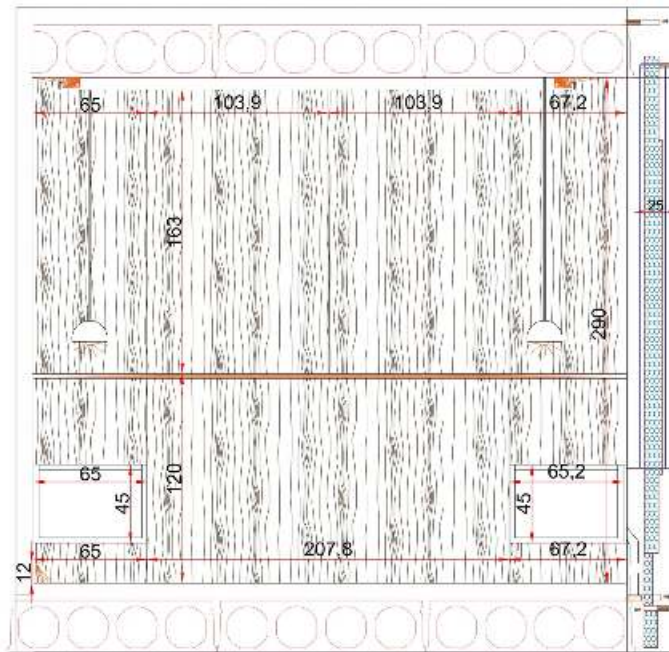



Master bedroom



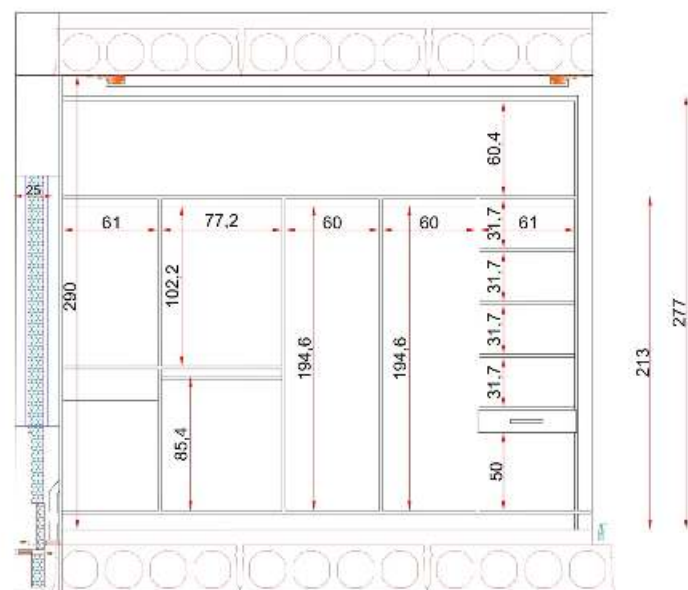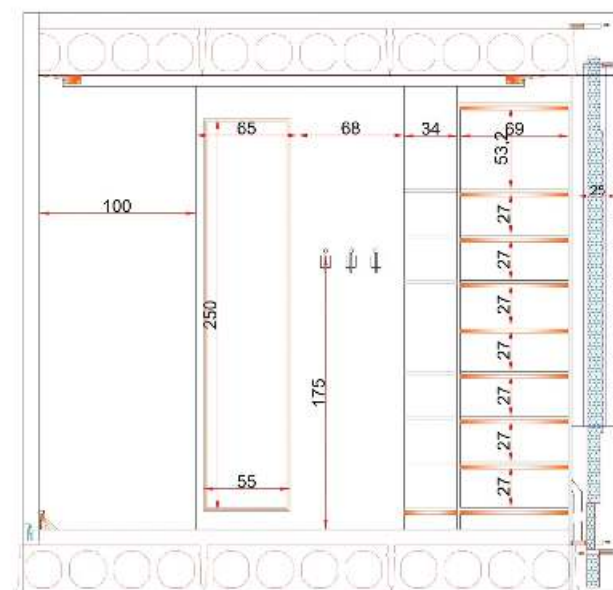



Master bedroom

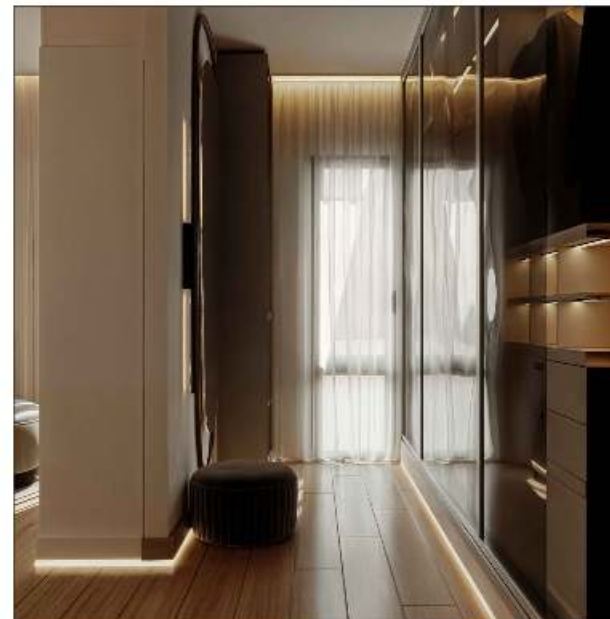

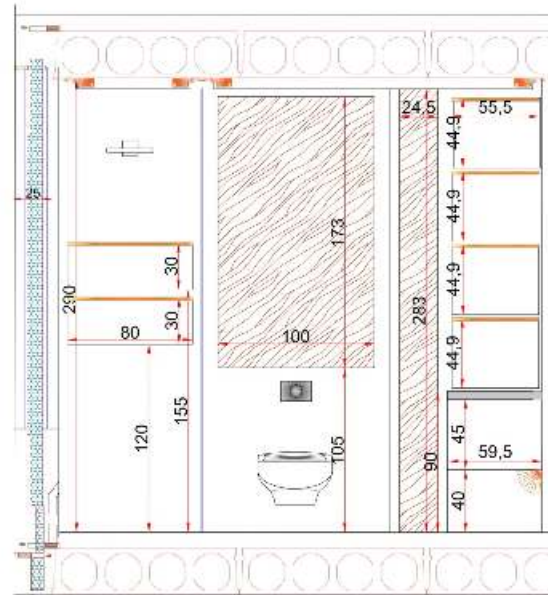

Master bedroom bath


MB-room BR

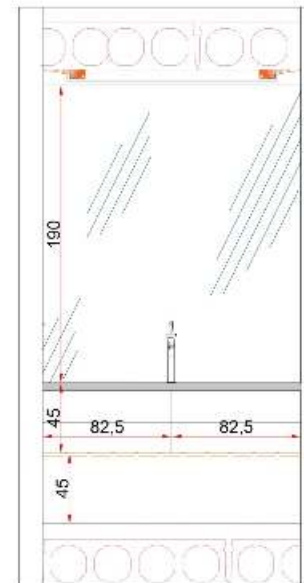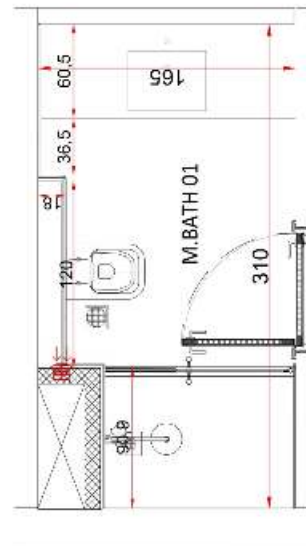



AL-FAROOQ ENGINEERING CONSULTING
Health Engineering Consulting

We Create
Your Dreams...

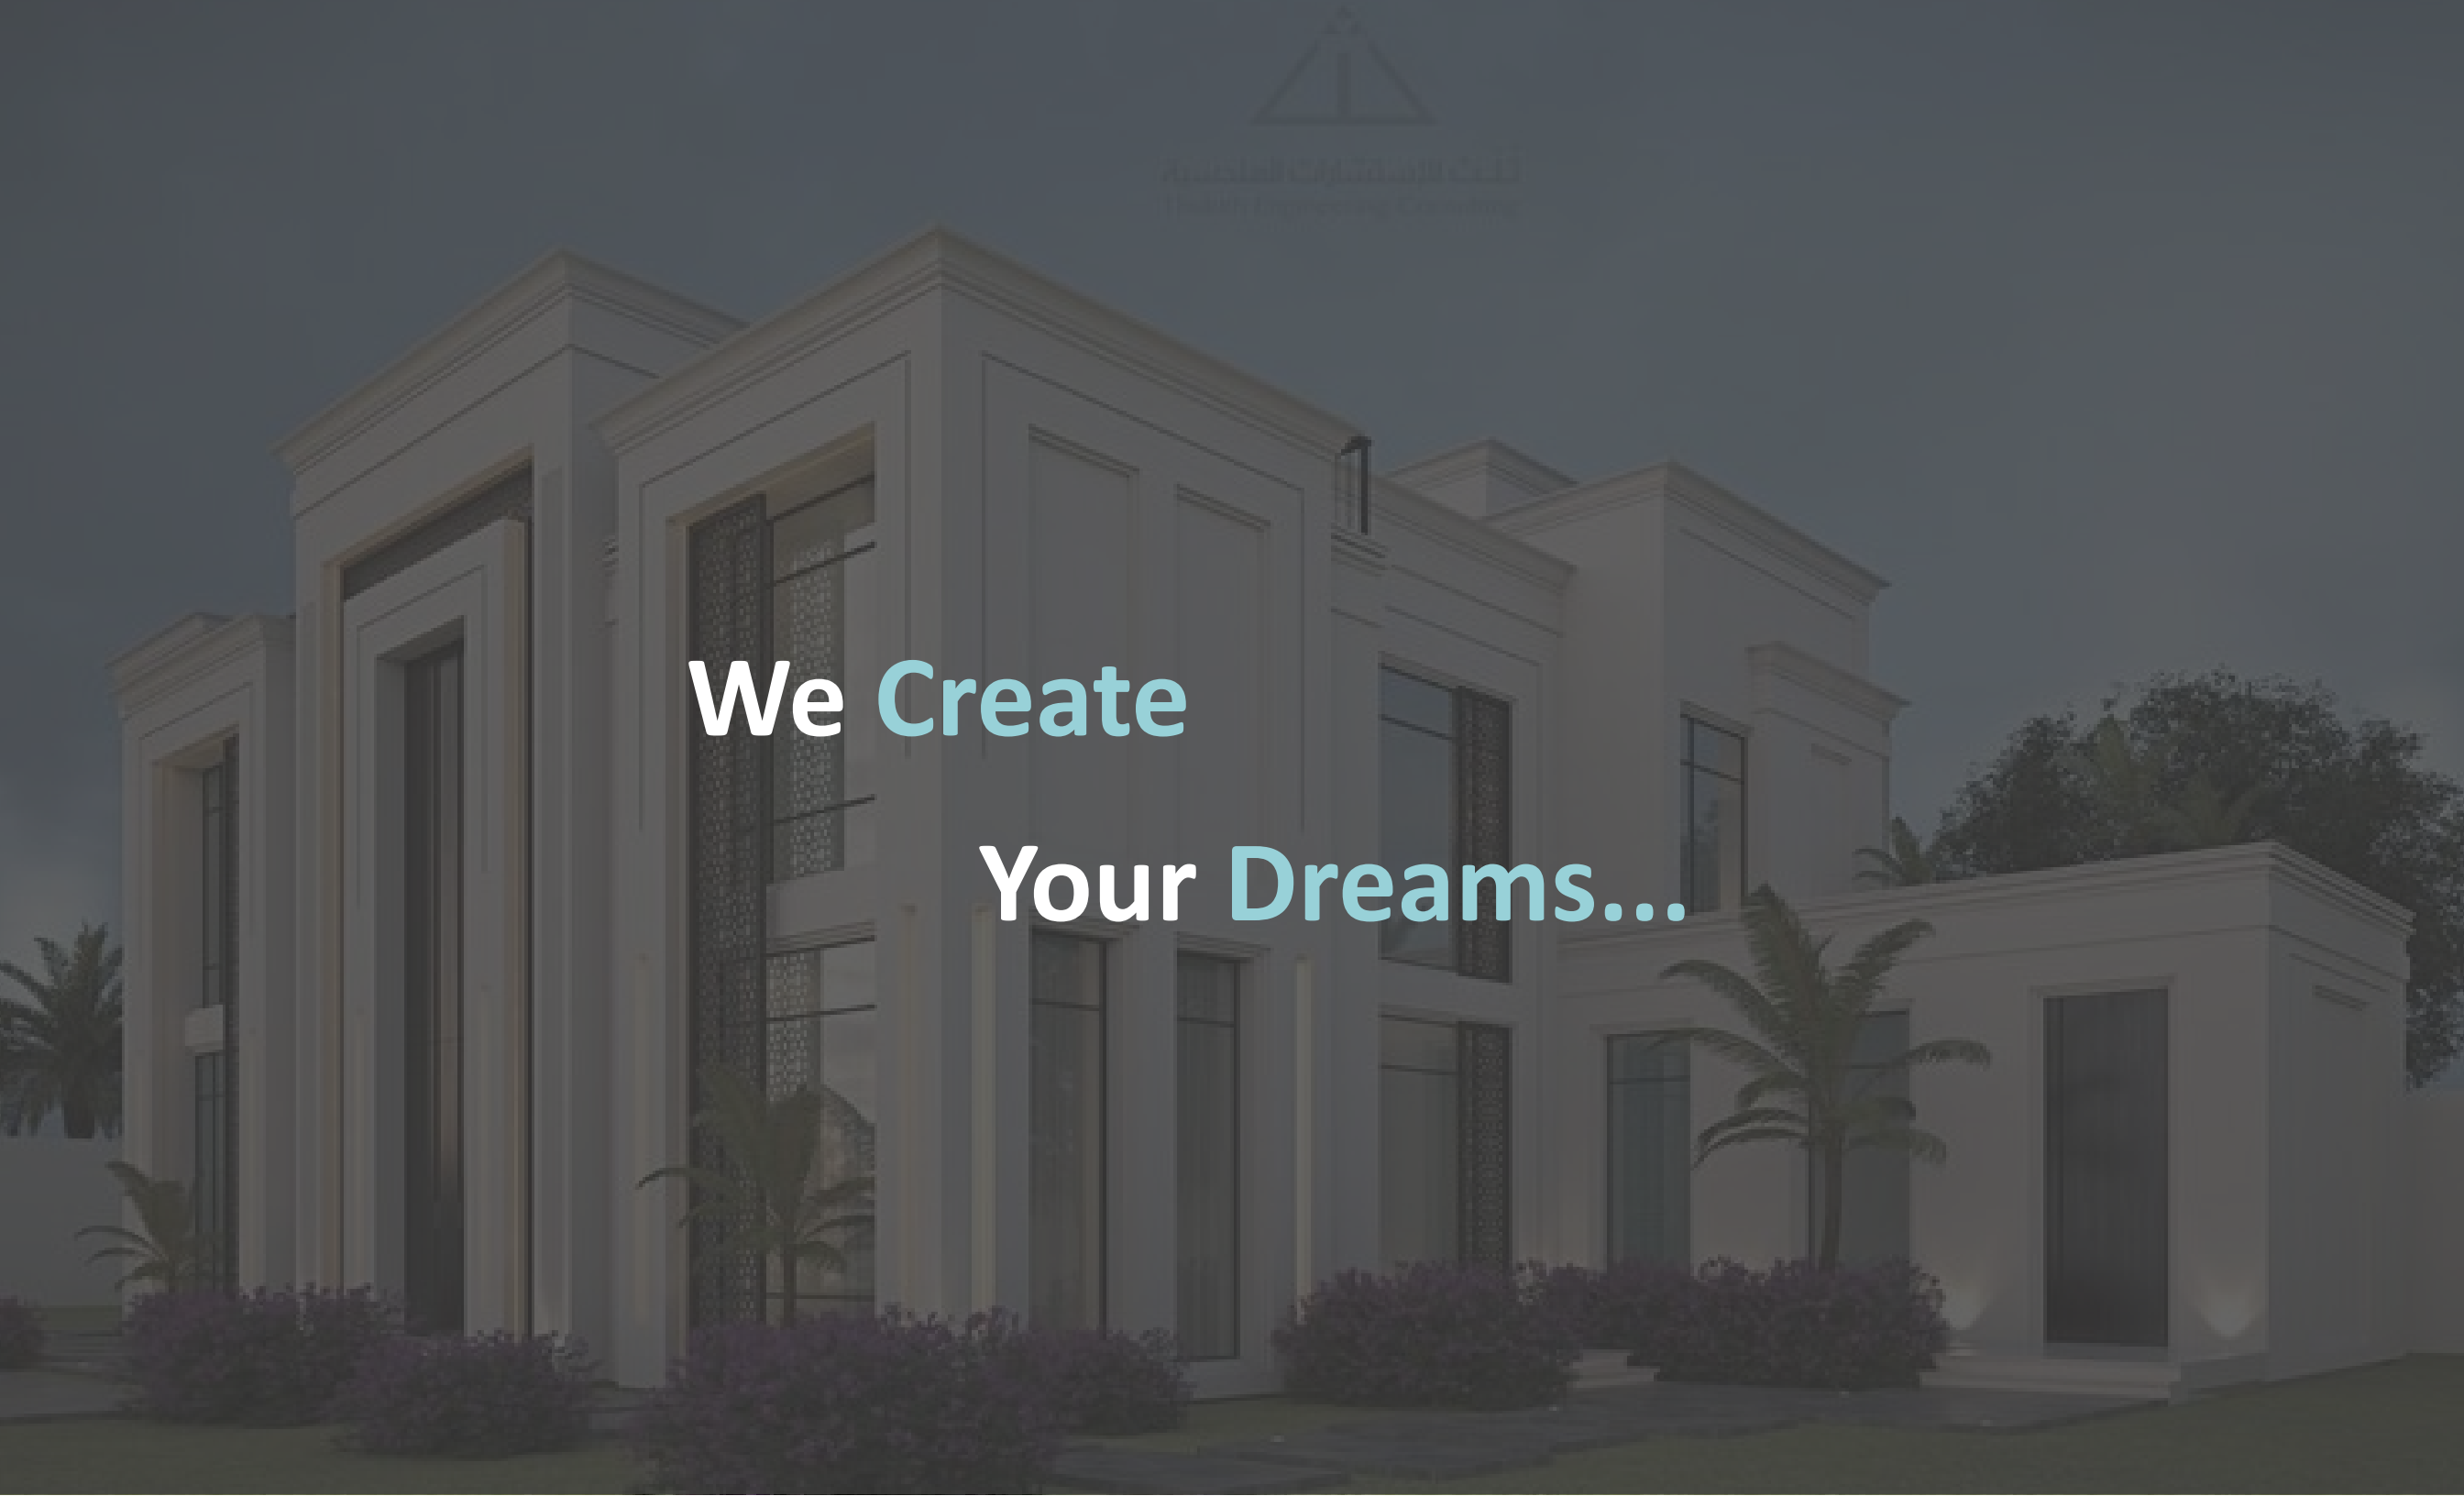



Architecture
Interior Design
Landscape

Architectural Leaders